

**SURVEY &
REMONUMENTATION**

APR 28 1995

**APPROVED LAND CORNER
P.A. 345 OF 1990
MIDLAND COUNTY**

**COMMISSION
REMON. COR. H-3, MT. HALEY TOWNSHIP
LAND CORNER RECORDATION CERTIFICATE
Filing Requirement of Act 74, Mich. P.A. 1970**

135

11/02/94 J.D.J.

For corners in
Midland
(County)

	Located in:	Corner Code #
1. Public Land Survey	T <u>13</u> N R <u>1E</u>	<u>H-3</u>
	T ___ R ___	_____
	T ___ R ___	_____
	T ___ R ___	_____
2. Property Controlling in Section	S ___ T ___ R ___	_____
	S ___ T ___ R ___	_____
3. Miscellaneous Property in Sec.	S ___ T ___ R ___	_____
	S ___ T ___ R ___	_____
4. Lot No. _____, Recorded Plat _____		
5. Private Claims _____		

STATE OF MICHIGAN
MIDLAND COUNTY
REMONUMENTATION & FILED

8 NOV 94 9:23 A.M.

BEVERLY J THAYER
REGISTER OF DEEDS

Register of Deeds Stamp & File Number

I, RODNEY CLAYPOOL, in a field survey on February 28, 1994, do hereby certify that under requirements of P.A. 74, Michigan P.A. of 1970, the corner points mentioned on lines 1 and 2 above were in conformance with regulations and rules therefore as required in the current manual of survey instructions of the United States Department of the Interior, Bureau of Land Management or by a decree of a Court of Law and/or that the corner points mentioned in lines 3, 4 and 5 above were in conformance with the rules of the Michigan Board of Land Surveyors or by a Decree of a Court of Law; re-established, monumented, re-monumented, recovered, found as expressed below:

NOTE: Not more than 4 corners, all in the same town and range, may be recorded on this certificate.

	A	B	C	D	E	F	G	H	I	J	K	L
2	6	5	4	3	2	1						
3												
4	7	8	9	10	11	12						
5												
6	18	17	16	15	14	13						
7												
8	19	20	21	22	23	24						
9												
10	30	29	28	27	26	25						
11												
12	31	32	33	34	35	36						
13												


A. Description of original monument and accessories and/or subsequent restoration:

H-3 Corner common to Sections 3 and 10

Government survey 1830's, set wood stake

Survey by J. Jones, 1980, set corner (PK) on straight line at midpoint between Section corners G-3 and I-3.

WITNESS NOTE: Witnesses from above surveys and LCRC's are available in dossier file; which was presented to peer review committee and is on file at the Register of Deeds Office.

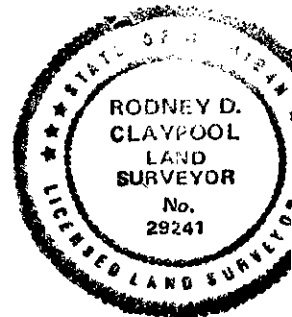

B. Description of corner evidence found and/or method applied in restoring or reestablishing corner:

H-3 Corner common to Sections 3 and 10

Found Ledy iron and cap (replaced with 5/8" rod and brass cap) per survey by J. Jones.

Corner H-3 was approved for remonumentation at a Peer Review Committee Meeting on Nov. 2, 1994

C. Description of monument for corner and accessories established to perpetuate locating the position of the corner:

H-3 Corner common to Sections 3 and 10

Found iron and cap (replaced with 5/8" rod and brass cap stamped Midland Co. Remon Cor. PS 29241 in mon box) per surveys by J. Jones; and accepted as the best available evidence of the accepted position of the corner.

N 70 Deg E, 101.75', nail in power pole

S 20 Deg W, 82.40', nail and plastic disc in power pole

N 50 Deg W, 42.59', nail and plastic disc in power pole

S 50 Deg E, 78.08', nail and plastic disc in 8" Oak

Signed by Rodney D. Claypool Date 11-04-94

Surveyor's Michigan License No. 29241

Form approved by Michigan State Board of Land Surveyors, Jan. 28, 1971

Revised May 14, 1971

Revised Jan., 1983