

NOV 07 1994

COMMISSION

929 1/13/94

48

REMON. COR. I-7, MT. HALEY TWP.
LAND CORNER RECORDATION CERTIFICATE
Filing Requirement of Act 74, Mich. P.A. 1970

For corners in
Midland

(County)

Located in: Corner Code #

- | | | |
|---------------------------------------|--------------------------|------------|
| 1. Public Land Survey | T <u>13N</u> R <u>1E</u> | <u>I-7</u> |
| | T ___ R ___ | _____ |
| | T ___ R ___ | _____ |
| | T ___ R ___ | _____ |
| 2. Property Controlling
in Section | S ___ T ___ R ___ | _____ |
| | S ___ T ___ R ___ | _____ |
| 3. Miscellaneous
Property in Sec. | S ___ T ___ R ___ | _____ |
| | S ___ T ___ R ___ | _____ |
| 4. Lot No. _____, Recorded Plat _____ | | |
| 5. Private Claims _____ | | |

STATE OF MICHIGAN
MIDLAND COUNTY
REMONUMENTATION & FILED

24 JAN 94 2:54 P.M.

BEVERLY J THAYER
REGISTER OF DEEDS

Register of Deeds Stamp & File Number

A B C D E F G H I J K L M

2	6	5	4	3	2	1
3						
4	7	8	9	10	11	12
5						
6	18	17	16	15	14	13
7						
8	19	20	21	22	23	24
9						
10	30	29	28	27	26	25
11						
12	31	32	33	34	35	36
13						

I, RODNEY CLAYPOOL, in a field survey on DECEMBER 6, 1993, do hereby certify that under requirements of P.A. 74, Michigan P.A. of 1970, the corner points mentioned on lines 1 and 2 above were in conformance with regulations and rules therefore as required in the current manual of survey instructions of the United States Department of the interior, Bureau of Land Management or by a decree of a Court of Law and/or that the corner points mentioned in lines 3, 4 and 5 above were in conformance with the rules of the Michigan Board of Land Surveyors or by a Decree of a Court of Law; re-established, monumented, re-monumented, recovered, found as expressed below:

NOTE: Not more than 4 corners, all in the same town and range, may be recorded on this certificate.

A. Description of original monument and accessories and/or subsequent restoration:

I-7 Corner common to Sections 14, 15, 22, 23

Wood post Government surveys 1832
Pine 34" N 17 Deg W, 23 L (15.18')
Maple 17" S 17 Deg E, 32 L (21.12')

Survey by J. Schafer 1973 found

Survey by J. Schafer 1974 found iron in mon box

Survey by Franklin Gibbs 1905
Found old post set new post


Survey by L. Urbaniak 1975 (recorded L 1 P 880)

S 40 Deg E, 52.78', W edge conc marker
S 35 Deg W, 122.30', NE cor Township Hall
N 50 Deg W, 53.30', East edge conc marker
(LCRC pg 857) by P. Lapham

Survey by D. Whittier 1965 (Job #6495)
set 3/4" pipe in mon box

Survey by M. Hunter 1968 found

Surveys J. Schafer 1979 found mon box

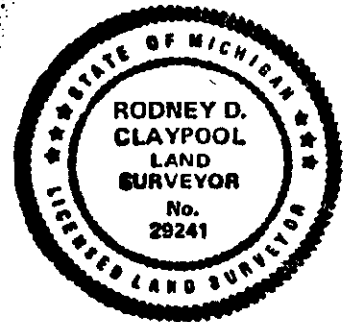

B. Description of corner evidence found and/or method applied in restoring or reestablishing corner:

I-7 Corner common to Sections 14, 15, 22, 23

Found 3/4" pipe in mon box
per L 1 P 890 and surveys by M. Hunter, J. Schafer, L. Urbaniak, LCRC #857 by P. Lapham

Corner I-7 was approved for remonumentation at a Peer Review Committee Meeting on JAN. 13, 1994

C. Description of monument for corner and accessories established to perpetuate locating the position of the corner:

I-7 Corner common to Sections 14, 15, 22, 23

3/4" pipe in mon box per recorded survey L 1 P 880 and is accepted as the best available evidence of the perpetuation of the corner.
Replaced 3/4" pipe with 5/8" re-rod stamped Midland Co. Remon Cor LS 29241.

S 40 Deg E, 55.14', found nail and disc in telephone pole stub
S 40 Deg E, 55.40', nail and plastic disc in telephone pole stub
S 50 Deg E, 89.76', nail and plastic disc in 12" Pine

N 45 Deg W, 40.64', found nail and disc in light pole
N 60 Deg W, 54.02', east edge project marker
N 47 Deg W, 74.93', nail and plastic disc in power pole

Signed by Rodney D. Claypool

Date 01-20-94

Surveyor's Michigan License No. 29241