

SURVEY &
REMONUMENTATION

NOV 07 1994

COMMISSION

APPROVED LAND-CORNER
P.A. 345 OF 1990
MIDLAND COUNTY

989 1/13/94

49

REMON. COR. I-9, MT. HALEY TWP.
LAND CORNER RECORDATION CERTIFICATE
Filing Requirement of Act 74, Mich. P.A. 1970

For corners in
Midland

(County)

Located in: Corner Code #

- | | | | |
|---------------------------------------|-------|--------------------------|------------|
| 1. Public Land Survey | | T <u>13N</u> R <u>1E</u> | <u>I-9</u> |
| | | T ___ R ___ | _____ |
| | | T ___ R ___ | _____ |
| | | T ___ R ___ | _____ |
| 2. Property Controlling
in Section | S ___ | T ___ R ___ | _____ |
| | S ___ | T ___ R ___ | _____ |
| 3. Miscellaneous
Property in Sec. | S ___ | T ___ R ___ | _____ |
| | S ___ | T ___ R ___ | _____ |
| 4. Lot No. _____, Recorded Plat _____ | | | |
| 5. Private Claims _____ | | | |

STATE OF MICHIGAN
MIDLAND COUNTY
REMONUMENTATION & FILED

24 JAN 94 2:54 P.M.

BEVERLY J THAYER
REGISTER OF DEEDS

Register of Deeds Stamp & File Number

I, RODNEY CLAYPOOL, in a field survey on DECEMBER 6, 1993, do hereby certify that under requirements of P.A. 74, Michigan P.A. of 1970, the corner points mentioned on lines 1 and 2 above were in conformance with regulations and rules therefore as required in the current manual of survey instructions of the United States Department of the interior, Bureau of Land Management or by a decree of a Court of Law and/or that the corner points mentioned in lines 3, 4 and 5 above were in conformance with the rules of the Michigan Board of Land Surveyors or by a Decree of a Court of Law; re-established, monumented, re-monumented, recovered, found as expressed below:

NOTE: Not more than 4 corners, all in the same town and range, may be recorded on this certificate.

	A	B	C	D	E	F	G	H	I	J	K	L	M
2	6	5	4	3	2	1							
3													
4	7	8	9	10	11	12							
5													
6	18	17	16	15	14	13							
7													
8	19	20	21	22	23	24							
9													
10	30	29	28	27	26	25							
11													
12	31	32	33	34	35	36							
13													

A. Description of original monument and accessories and/or subsequent restoration:

I-9 Corner common to Sections 22, 23, 26, 27

Wood post Government survey 1832
Elm 18", North, 9 L (5.94')
Elm 22", S 43 Deg E, 15 L (9.9')


N 45 Deg E, 41.81', found nail and disc in telephone pole
S 70 Deg W, 36.34, chiseled notch in south end C.M.P.
S 45 Deg W, 84.39', found nail and disc in power pole.

Surveys by F. T. Gibbs 1905, found wood post
Surveys by F. T. Gibbs 1909, found wood post

Survey by D. Ledy L 4 P 405 1989, found 1/4" iron bar
N 45 Deg E, 41.27', to telephone pole
S 30 Deg W, 84.41', to power pole
N 30 Deg W, 82.75', to 24" Maple

Survey by J. Schafer 1973, found 3" wood stake
stones around flat stone on top, set 1/2" rod in center
of wood stake, placed flat stone on South side of rod
(post 2 1/2' ± deep)
LCRC (July 1973)
N 30 Deg W, 82.57', found nail and disc in 18" Maple

LCRC #857 Paul B. Lapham
N 45 Deg E, 41.82', telephone pole
S 30 Deg W, 84.41', power pole
N 30 Deg W, 82.75', to 24" Maple

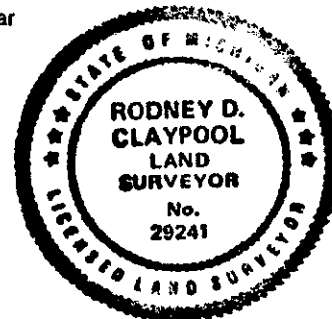

B. Description of corner evidence found and/or method applied in restoring or reestablishing corner:

I-9 Corner common to Sec. 22, 23, 26, and 27

Found 3/8" rod in mon box per recorded survey L 4 P 405 and
surveys by F. Gibbs, J. Schafer, LCRC by J. Schafer, P. Lapham

Corner I-9 was approved for remonumentation at a Peer Review Committee Meeting on JAN. 13, 1994

C. Description of monument for corner and accessories established to perpetuate locating the position of the corner:

I-9 Corner common to Sec. 22, 23, 26 and 27

3/8" rod in mon box per recorded survey L 4, P 405 and other survey and is accepted as the best available evidence of the position of the original
Corner. Replace 3/8" rod with 5/8" rod and brass cap stamped Midland Co. Remon Cor. PS 29241
S 45 Deg W, 84.40', found nail and plastic disc in power pole
S 45 Deg E, 34.12", "+" in concrete pipe (east end)
N 45 Deg E, 35.61', N end 18" CMP
N 45 Deg W, 46.62', N end 18" CMP

Signed by Rodney D. Claypool

Date 01-20-94

Surveyor's Michigan License No. 29241

Form approved by Michigan State Board of Land Surveyors, Jan. 28, 1971

Revised May 14, 1971

Revised Jan 1983