

NOV 07 1994

*949 2/19/94*

COMMISSION

REMON. COR. K-7, MT. HALEY TWP. LAND CORNER RECORDATION CERTIFICATE Filing Requirement of Act 74, Mich. P.A. 1970

For corners in Midland (County)

Located in: Corner Code #

- 1. Public Land Survey T 13N R 1E K-7
2. Property Controlling in Section S T R
3. Miscellaneous Property in Sec. S T R
4. Lot No. Recorded Plat
5. Private Claims

59

STATE OF MICHIGAN MIDLAND COUNTY FILED

24 FEB 94 3:16 P.M.

Register of Deeds State of Michigan

REGISTER OF DEEDS


Table with columns A-M and rows 2-13 containing numbers 1-36 in a grid format.

I, RODNEY CLAYPOOL, in a field survey on NOVEMBER 30, 1993, do hereby certify that under requirements of P.A. 74, Michigan P.A. of 1970, the corner points mentioned on lines 1 and 2 above were in conformance with regulations and rules therefore as required in the current manual of survey instructions of the United States Department of the interior, Bureau of Land Management or by a decree of a Court of Law and/or that the corner points mentioned in lines 3, 4 and 5 above were in conformance with the rules of the Michigan Board of Land Surveyors or by a Decree of a Court of Law; re-established, monumented, re-monumented, recovered, found as expressed below:

NOTE: Not more than 4 corners, all in the same town and range, may be recorded on this certificate.

A. Description of original monument and accessories and/or subsequent restoration:

- K-7 Corner common to Section 13, 14, 23, and 24 Wood post Government survey 1832 No witnesses
Survey by F.T. Gibbs 1905 found corner post standing Survey by M. Hunter 1968 found corner
Survey by D. Whittier 1972 found 1/2" x 1" iron bar in old wood post LCRC 1972 D. Whittier S 30 Deg W, tag in telephone pole, 60.35' S 60 Deg W, centerline R/W marker, 67.0' W 40 Deg W, face power pole, 72.5'
Survey by L. Urbaniak 1975 L 1 P 880 Found 1/2" pipe N 45 Deg W, 73.18" power pole S 80 Deg W, 66.90', NE edge conc marker S 30 Deg W, 60.38', telephone pole LCRC #257 July 28, 1975 (P. Lapham)
Survey by J. Jones 1979 found corner
LCRC by H. Fluharty #410 (1976) Found 3/8" pipe power pole S 31 Deg W, 60.40' Willow S 60 Deg W, 53.81' S end 15" CMP S 50 Deg E, 39.84'

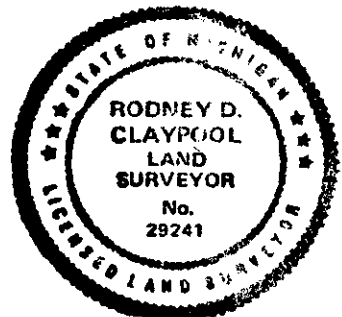

B. Description of corner evidence found and/or method applied in restoring or reestablishing corner:

- K-7 Corner Common to Sec. 13, 14, 23 & 24 Found 1/2" pipe in mon box per rec survey L 1 P 880; and surveys by M. Hunter, D. Whittier, J. Jones, and LCRC by P. Lapham, D. Whittier, H. Fluharty.

Corner K-7 was approved for remonumentation at a Peer Review Committee Meeting on FEB 10, 1994.

C. Description of monument for corner and accessories established to perpetuate locating the position of the corner:

- K-7 Corner common to Sec. 13, 14, 23, & 24 1/2" pipe in mon box per rec survey L 1 P 880 and others and is accepted as the perpetuation of the original corner Replaced 1/2" pipe with 5/8" re-rod & brass cap stamped Midland Co. Remon cor PS 29241
S 30 Deg E, 184.06', nail and plastic disc in power pole
S 30 Deg W, 60.47', nail and plastic disc in telephone pole stub
S 60 Deg W, 102.94', nail and plastic disc in power pole
N 45 Deg W, 73.20', nail and plastic disc in power pole
S 80 Deg W, 66.95', N edge conc marker

Signed by Rodney D. Claypool Date 02-23-94

Surveyor's Michigan License No. 29241