

SURVEY &
REMONUMENTATION

NOV 07 1994

COMMISSION

REMON. COR. K-8, MT. HALEY TWP.
LAND CORNER RECORDATION CERTIFICATE
Filing Requirement of Act 74, Mich. P.A. 1970

APPROVED LAND CORNER
P.A. 345 OF 1990
MIDLAND COUNTY

95 2/10/94

For corners in
Midland
(County)

Located in: Corner Code #

- | | | |
|---------------------------------------|--|------------|
| 1. Public Land Survey | T <u>13</u> N R <u>1E</u> | <u>K-8</u> |
| | T <u> </u> R <u> </u> | <u> </u> |
| | T <u> </u> R <u> </u> | <u> </u> |
| | T <u> </u> R <u> </u> | <u> </u> |
| 2. Property Controlling in Section | S <u> </u> T <u> </u> R <u> </u> | <u> </u> |
| | S <u> </u> T <u> </u> R <u> </u> | <u> </u> |
| 3. Miscellaneous Property in Sec. | S <u> </u> T <u> </u> R <u> </u> | <u> </u> |
| | S <u> </u> T <u> </u> R <u> </u> | <u> </u> |
| 4. Lot No. _____, Recorded Plat _____ | | |
| 5. Private Claims _____ | | |

60

STATE OF MICHIGAN
MIDLAND COUNTY
FILED
24 FEB 94 3:16 P.M.
BEVERLY J THAYER
REGISTER OF DEEDS


I, RODNEY CLAYPOOL, in a field survey on NOVEMBER 30, 1993, do hereby certify that under requirements of P.A. 74, Michigan P.A. of 1970, the corner points mentioned on lines 1 and 2 above were in conformance with regulations and rules therefore as required in the current manual of survey instructions of the United States Department of the interior, Bureau of Land Management or by a decree of a Court of Law and/or that the corner points mentioned in lines 3, 4 and 5 above were in conformance with the rules of the Michigan Board of Land Surveyors or by a Decree of a Court of Law; re-established, monumented, re-monumented, recovered, found as expressed below:

	A	B	C	D	E	F	G	H	I	J	K	L	M
2	6	5	4	3	2	1							
3													
4	7	8	9	10	11	12							
5													
6	18	17	16	15	14	13							
7													
8	19	20	21	22	23	24							
9													
10	30	29	28	27	26	25							
11													
12	31	32	33	34	35	36							
13													

NOTE: Not more than 4 corners, all in the same town and range, may be recorded on this certificate.

A. Description of original monument and accessories and/or subsequent restoration:

- | | | |
|-----|--|--|
| K-8 | 1/4 corner common to Sec. 23 and 24 | LCRC #257 P. Lapham 1975 found railroad spike
S 35 Deg E, 100.15', power pole |
| | Wood post Government survey 1832 | N 85 Deg W, 53.69', telephone pole |
| | B. Ash 30", N 38 Deg W, 7 L (4.62') | N 30 Deg W, 130.80', telephone pole |
| | Sycamore 7", S 34 Deg E, 22 L (14.52') | LCRC #410 H. Fluharty 1976 found rail road spike |
| | Survey by F.T. Gibbs 1905, found old 1/4 corner | N 85 Deg W, 53.57', power pole |
| | Survey by D. Whittier, 1972, L 1 P 265, set railroad spike for 1/4 corner on straight line at midpoint between K-7 and K-9 | N 21 Deg W, 134.75', power pole |
| | N 87 Deg W, tag in telephone pole 53.62' | S 32 Deg E, 100.15', power pole |
| | S 35 Deg E, tag in power pole, 100.20' | Survey by D. Ledy L 4 P 592 (1989) |
| | (LCRC Dec. 26, 1972 D. Whittier) | Found railroad spike, West, 53.50', nail and tag in telephone pole |
| | | NNW, 134.74', nail and tag in telephone pole |
| | | SE, 100.04', nail and tag in power pole |

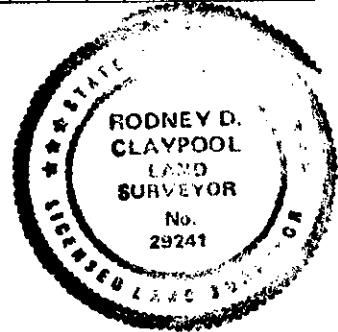

B. Description of corner evidence found and/or method applied in restoring or reestablishing corner:

- K-8 1/4 Corner Common to Sec. 23 and 24, old corner gone
Set 5/8" re-rod with brass cap stamped Midland co. Remon Co. PS 29241 and mon box on straight line at midpoint between K7 and K9 per rec. Survey L 1 P 265; L 4 P 592 and LCRC by P. Lapham, H. Fluharty, D. Whittier

Corner K-8 was approved for remonumentation at a Peer Review Committee Meeting on FEB. 10, 1994

C. Description of monument for corner and accessories established to perpetuate locating the position of the corner:

- K-8 1/4 corner common to Sec. 23 and 24
Set 5/8" re-rod and brass cap stamped Midland Co. Remon Cor PS 29241 in mon box per reg. survey L 1 P 265 and is accepted as a careful and faithful re-establishment of the position of the original corner
S 35 Deg E, 100.12', nail and disc in power pole
N 85 Deg W, 53.68', nail and disc in telephone pole
N 30 Deg W, 134.78', nail and disc in telephone pole
N 10 Deg E, 322.39', nail and plastic disc in power pole
North, K-7, 2645.30'
South, K-9, 2645.30'

Signed by Rodney D. Claypool Date 02-23-94