

NOV 07 1994

COMMISSION

929 2/10/94

REMON. COR. M-5, MT. HALEY TWP. LAND CORNER RECORDATION CERTIFICATE Filing Requirement of Act 74, Mich. P.A. 1970

51

For corners in Midland (County)

Located in: Corner Code #

Table with 3 columns: Survey Type, Located in (T/R/S), and Corner Code #. Includes rows for Public Land Survey, Property Controlling in Section, and Miscellaneous Property in Sec.

4. Lot No. Recorded Plat 5. Private Claims

STATE OF MICHIGAN MIDLAND COUNTY FILED 24 FEB 94 3:14 P.M. BEVERLY J THAYER REGISTER OF DEEDS Register of Deeds Stamp & File Number


I, RODNEY CLAYPOOL, in a field survey on DECEMBER 3, 1993, do hereby certify that under requirements of P.A. 74, Michigan P.A. of 1970, the corner points mentioned on lines 1 and 2 above were in conformance with regulations and rules therefore as required in the current manual of survey instructions of the United States Department of the Interior, Bureau of Land Management or by a decree of a Court of Law and/or that the corner points mentioned in lines 3, 4 and 5 above were in conformance with the rules of the Michigan Board of Land Surveyors or by a Decree of a Court of Law; re-established, monumented, re-monumented, recovered, found as expressed below:

Grid table with columns A-M and rows 2-13. Contains numbers 1-36 in a grid pattern.

NOTE: Not more than 4 corners, all in the same town and range, may be recorded on this certificate.

A. Description of original monument and accessories and/or subsequent restoration:

M-5 Corner common to Sections 12 and 13 T13N-R1E and Sections 7 and 18 T13N-R2E. Wood post Government survey 1832 Survey by D. Whittier 1966 and 1969, found 2" pipe Survey by J. Schafer 1971, found corner Survey by R. Strejc 1973, found 1 1/8" pipe S edge Brooks Road, 5/8" pipe 33' N NE cor HSE S 10 Deg E, 49.4' 12" Maple, S 15 Deg W, 34.6' 20" Pine, N 10 Deg W, 89.6'

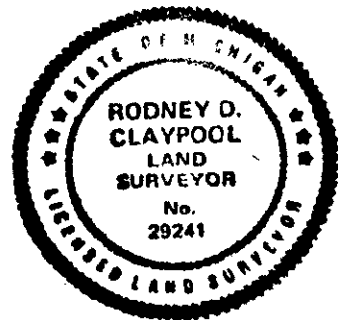

B. Description of corner evidence found and/or method applied in restoring or reestablishing corner:

M-5 Corner common to Sections 12 and 13 T13N-R1E and Sections 7 and 18 T13N-R2E Found bolt in mon box per County Road Commission and surveys by M. Hunter, D. Whittier, J. Schafer, and R. Strejc

Corner M-5 was approved for remonumentation at a Peer Review Committee Meeting on FEB 10, 1994.

C. Description of monument for corner and accessories established to perpetuate locating the position of the corner:

M-5 Corner common to Sections 12 and 13 T13N-R1E and Sections 7 and 18 T13N-R2E Found bolt in mon box (removed bolt and set 5/8" rod with brass cap stamped Midland Co. Remon cor PS 29241) per survey by M. Hunter, D. Whittier, J. Schafer and R. Strejc and is accepted as the best available evidence of the perpetuation of the accepted corner S 45 Deg W, 90.26', nail and plastic disc in power pole N 45 Deg E, 63.25', nail and plastic disc in Maple clump N 10 Deg E, 41.46', nail and plastic disc in Maple clump N 15 Deg W, 89.50', nail and plastic disc in 30" White Pine

Signed by Rodney D. Claypool Date 02-23-94

Surveyor's Michigan License No. 29241