

JAN 21 1998

APPROVED LAND CORNER
P.A. 345 OF 1990
MIDLAND COUNTY

REMON. CORNER D-3, PORTER TWP.
LAND CORNER RECORDATION CERTIFICATE
Filing Requirement of Act 74, Mich. P.A. 1970

SECTION 385

For corners in
MIDLAND
(County)

- | | Located in: | Corner Code # |
|---------------------------------------|--------------------------|---------------|
| 1. Public Land Survey | T <u>13N</u> R <u>1W</u> | <u>D-3</u> |
| | T ___ R ___ | _____ |
| | T ___ R ___ | _____ |
| | T ___ R ___ | _____ |
| 2. Property Controlling in Section | S ___ T ___ R ___ | _____ |
| | S ___ T ___ R ___ | _____ |
| 3. Miscellaneous Property in Sec. | S ___ T ___ R ___ | _____ |
| | S ___ T ___ R ___ | _____ |
| 4. Lot No. _____, Recorded Plat _____ | | |
| 5. Private Claims _____ | | |

STATE OF MICHIGAN
MIDLAND COUNTY
REMONUMENTATION & FILED

12/16/1998 12:11:56 PM

BEVERLY J. THAYER
REGISTER OF DEEDS

Register of Deeds Stamp & File Number


I, RODNEY CLAYPOOL, in a field survey on June 19, 1998, do hereby certify that under requirements of P.A. 74, Michigan P.A. of 1970, the corner points mentioned on lines 1 and 2 above were in conformance with regulations and rules therefore as required in the current manual of survey instructions of the United States Department of the Interior, Bureau of Land Management or by a decree of a Court of Law and/or that the corner points mentioned in lines 3, 4 and 5 above were in conformance with the rules of the Michigan Board of Land Surveyors or by a Decree of a Court of Law; re-established, monumented, re-monumented, recovered, found as expressed below:

NOTE: Not more than 2 corners, all in the same town and range, may be recorded on this certificate.

	A	B	C	D	E	F	G	H	I	J	K	L	M
2	6	5	4	3	2	1							
3													
4	7	8	9	10	11	12							
5													
6	18	17	16	15	14	13							
7													
8	19	20	21	22	23	24							
9													
10	30	29	28	27	26	25							
11													
12	31	32	33	34	35	36							
13													

A. Description of original monument and accessories and/or subsequent restoration:

- D-3 1/4 Corner common to Sections 5 and 8
- Survey by Glo, 1830's, set post
 - Survey by F. Gibbs, 1906, stone old corner
 - LCRC by Courtright, 1971, found 3/4" pipe
 - Survey by Ruddell Engineering, 1972, found 3/4" pipe
 - Survey by Ayres Associates, 1990, found.
 - Survey by Ledy, 1996, found 3/4" pipe on side, reset.

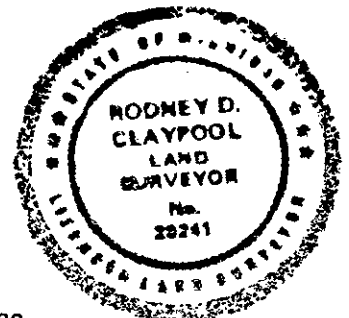

WITNESS NOTE: Witnesses from above surveys and LCRC's are available in dossier file; which was presented to peer review committee and is on file at the Register of Deeds Office.

B. Description of corner evidence found and/or method applied in restoring or reestablishing corner:

- D-3 1/4 Corner common to Sections 5 and 8
- Found Ledy iron and cap per surveys by F. Gibbs, Ruddell Engineering, Ayres Associates, Ledy and LCRC by Courtright. Dug 3' ±, found nothing.

C. Description of monument for corner and accessories established to perpetuate locating the position of the corner:

- D-3 1/4 Corner common to Sections 5 and 8
- Found Ledy iron and cap per surveys by F. Gibbs, Ruddell Engineering, Ayres Associates and Ledy, replaced rod with 5/8" rod and brass cap stamped Midland Co. Remon Cor. PS 29241, and is accepted as the best available evidence of the position of the accepted corner.
- S 60 Deg E, 125.16 ft, nail and plastic disc in 24" Cottonwood
 - N 15 Deg E, 163.40 ft, Southwest corner concrete pad for trans. box
 - N 10 Deg W, 134.16 ft, nail and plastic disc in power pole
 - N 45 Deg W, 59.75 ft, nail in power pole (Rec. 59.76, 59.3)

Signed by Rodney D. Claypool Date 12-04-98

Surveyor's Michigan License No. 29241