

APPROVED CORNER  
P.A. 345 OF 1990  
MIDLAND COUNTY

LAND CORNER RECORDATION CERTIFICATE  
Filing Requirement of Act 74, Mich. P.A. 1970

*7/29 6/6/95*

For corners in

<u>MIDLAND</u> (County)	Located In:	Corner Code #
1. Public Land Survey	T <u>13N</u> R <u>1W</u>	<u>G-9</u>
	T _____ R _____	_____
	T _____ R _____	_____
	T _____ R _____	_____
2. Property Controlling in Section	S _____ T _____ R _____	_____
	S _____ T _____ R _____	_____
3. Miscellaneous Property in Sec.	S _____ T _____ R _____	_____
	S _____ T _____ R _____	_____
4. Lot No. _____, Recorded Plat _____		
5. Private Claims _____		

220


STATE OF MICHIGAN  
MIDLAND COUNTY  
FILED

19 JUL 95 10:53 A.M.

BEVERLY J THAYER  
REGISTER OF DEEDS  
Register of Deeds Stamp & File Number

I, PAUL B. LAPHAM, in a field survey on MAY, 19 95, do hereby certify that under requirements of P.A. 74, Michigan P.A. of 1970, the corner points mentioned in lines 1 and 2 above were in conformance with regulations and rules therefore as required in the current manual of survey instructions of the United States Department of the Interior, Bureau of Land Management or by a decree of a Court of Law and/or that the corner points mentioned in lines 3, 4 and 5 above were in conformance with the rules of the Michigan Board of Land Surveyors or by a Decree of a Court of Law; established, re-established, monumented, re-monumented, recovered, found as expressed below:

**NOTE: Not more than 4 corners, all in the same town and range, may be recorded on this certificate.**

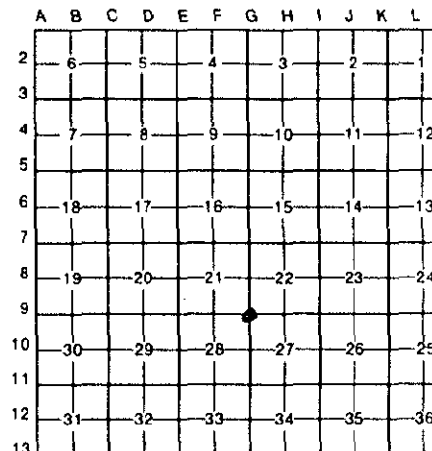

A. Description of original monument and accessories and/or subsequent restoration:

- G-9 Corner common to Sections 22, 21, 28 and 27
- 1852 AUSTIN BURT POST NO WITNESSES
- 1901 GIBBS, STONE, STONE AROUND OLD CORNER
- 11-9-72 HUNTER, CORNER FOUND (132) SURVEY
- 11-4-75 DAVID WHITTIER, NO CORNER MATERIAL NOTED L.C.R.C.
- 7-31-81 THOMAS MUELLER, PIPE IN MON. BOX
- 6-25-92 JAN FOKENS, FOUND STONE, 1/2" PIPE

WITNESS NOTE: Witness from above surveys and LCRC's are available in dossier file; which was presented to peer review committee and is on file at the Register of Deeds Office.

B. Description of corner evidence found and/or method applied in restoring or reestablishing corner:

- G-9 Corner common to Sections 22, 21, 28 and 27
- Found 3/4" x 18" pipe with large stones around it per surveys by Gibbs, Hunter, Whittier, Mueller & Fokens.

SURVEY &  
REMONUMENTATION

NOV 1995


COMMISSION

Corner, G-9 was approved for remonumentation at a Peer Review Committee Meeting on 6-6, 19 95.

C. Description of monument for corner and accessories established to perpetuate locating the position of the corner:

- G-9 Corner common to Sections 22, 21, 28 and 27
- Set 5/8" x 18" re-rod with brass cap stamped "Midland Co. Remon. Cor. PS 9433" in Monument Box. Accepted as best available evidence of perpetuation of original corner.

- N40°W 48.02' - N&D IN E. FACE POWER POLE
- S35°E 47.55' - N&D IN SW FACE POWER POLE
- S75°W 43.82' - STOP & ROAD SIGN POST
- N20°E 141.95' - N& L.S.C. TAG IN SE. FACE POWER POLE
- SW 30.61' - N&C IN BRIDGE HEADWALL

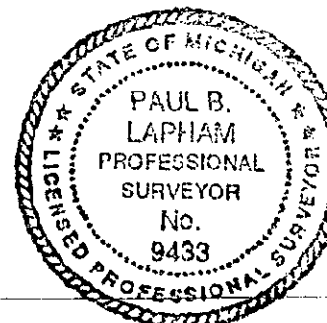

Signed by Paul B. Lapham  
Surveyor's Michigan License No. 9433

Date 6-12-95