

SURVEY &  
REMONUMENTATION

NOV 07 1994

COMMISSION

REMON. COR. A-11, INGERSOLL TWP.  
LAND CORNER RECORDATION CERTIFICATE  
Filing Requirement of Act 74, Mich. P.A. 1970

APPROVED LAND CORNER  
P.A. 345 OF 1990  
MIDLAND COUNTY

*919 2/10/94*

53

For corners in  
Midland

(County)

Located in: Corner Code #

- |                                       |                            |             |
|---------------------------------------|----------------------------|-------------|
| 1. Public Land Survey                 | T <u>13</u> N R <u>2</u> E | <u>A-11</u> |
|                                       | T ___ R ___                | _____       |
|                                       | T ___ R ___                | _____       |
|                                       | T ___ R ___                | _____       |
| 2. Property Controlling<br>in Section | S ___ T ___ R ___          | _____       |
|                                       | S ___ T ___ R ___          | _____       |
| 3. Miscellaneous<br>Property in Sec.  | S ___ T ___ R ___          | _____       |
|                                       | S ___ T ___ R ___          | _____       |
4. Lot No. \_\_\_\_\_, Recorded Plat \_\_\_\_\_
5. Private Claims \_\_\_\_\_

STATE OF MICHIGAN  
MIDLAND COUNTY  
FILED  
24 FEB 94 3:15 P.M.  
BEVERLY J THAYER  
REGISTER OF DEEDS

A B C D E F G H I J K L M


2	6	5	4	3	2	1
3						
4	7	8	9	10	11	12
5						
6	18	17	16	15	14	13
7						
8	19	20	21	22	23	24
9						
10	30	29	28	27	26	25
11						
12	31	32	33	34	35	36
13						

I, RODNEY CLAYPOOL, in a field survey on DECEMBER 6, 1993, do hereby certify that under requirements of P.A. 74, Michigan P.A. of 1970, the corner points mentioned on lines 1 and 2 above were in conformance with regulations and rules therefore as required in the current manual of survey instructions of the United States Department of the Interior, Bureau of Land Management or by a decree of a Court of Law and/or that the corner points mentioned in lines 3, 4 and 5 above were in conformance with the rules of the Michigan Board of Land Surveyors or by a Decree of a Court of Law; re-established, monumented, re-monumented, recovered, found as expressed below:

**NOTE: Not more than 4 corners, all in the same town and range, may be recorded on this certificate.**

A. Description of original monument and accessories and/or subsequent restoration:

- A-11 Corner common to Sections 30 and 31  
Wood post Government survey 1830's  
Int. West BDY 23 L (15.18') South  
Hemlock 9" S 41 Deg E, 34 L. (22.44')  
Birch 12", N 15 1/2 Deg E, 20 L. (13.2')  
Survey by D. Whittier (1970), Set 3/4" pipe in mon box by lining over SE cor and E 1/4 cor of Sec 25, T13N-R1E Mt. Haley Twp., and going 15.18' (Gov. Dist) South  
Survey by D. Whittier 1972, found 3/4" pipe in mon box
- Survey by A. Leach 1975, found 3/4" pipe  
Survey by J. Schafer, found 3/4" pipe, 15.18'  
S of SE cor Sec. 25 (mon box) Mt. Haley Twp., T13N-R1E  
1' S of S edge blacktop, S 35 Deg W, tag in Power pole 53.41'  
LCRC A. Leach (1975) # 243, found 3/4" pipe  
N 20 Deg E, 95.25', to top telephone riser  
North, 15.18' to pipe in mon box  
which is NE cor Sec. 36 Mt. Haley Twp, T13N-R1E  
S 45 Deg W, 42.7' to pipe line marker

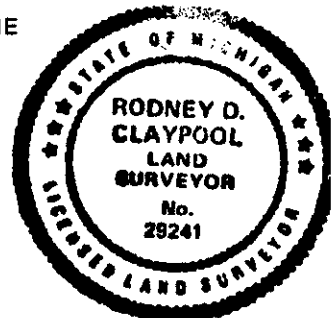

B. Description of corner evidence found and/or method applied in restoring or reestablishing corner:

- A-11 Corner common to Sections 30 and 31  
Found 3/4" pipe in mon box per surveys by D. Whittier, A. Leach, and J. Schafer

Corner A-11 was approved for remonumentation at a Peer Review Committee Meeting on FEB 10, 1994.

C. Description of monument for corner and accessories established to perpetuate locating the position of the corner:

- A-11 Corner common to Sections 30 and 31  
Found 3/4" pipe in mon box (removed pipe, set 3/4" pipe with brass cap stamped Midland Co. Remon Cor. PS 29241) per surveys by D. Whittier, A. Leach and J. Schafer and is accepted as the best available evidence of the position of the original corner.  
North, 15.18', 3/4" pipe in mon box  
0.05' East of controlling East Mt. Haley Township (T13N-R1E) line M-11 and M-12  
S 40 Deg W, 53.46', nail and disc in power pole  
N 60 Deg W, 42.80', "+" on top of project marker  
N 25 Deg E, 95.50', Nail and disc in telephone pole stub  
N 30 Deg W, 48.85', Northwesterly bolt on W end CMP

Signed by Rodney D. Claypool

Date 02-23-94

Surveyor's Michigan License No. 29241