

SURVEY &
REMONUMENTATION

NOV 07 1994

COMMISSION

REMON. COR. D-7 INGERSOLL TWP.
LAND CORNER RECORDATION CERTIFICATE
Filing Requirement of Act 74, Mich. P.A. 1970

APPROVED LAND-CORNER
P.A. 345 OF 1990
MIDLAND COUNTY

JPJ 1/13/94

39

For corners in
Midland

(County)	Located in:	Corner Code #
1. Public Land Survey	T <u>13N</u> R <u>2E</u>	<u>D-7</u>
	T ___ R ___	_____
	T ___ R ___	_____
	T ___ R ___	_____
2. Property Controlling in Section	S ___ T ___ R ___	_____
	S ___ T ___ R ___	_____
3. Miscellaneous Property in Sec.	S ___ T ___ R ___	_____
	S ___ T ___ R ___	_____
4. Lot No. _____, Recorded Plat _____		
5. Private Claims _____		

STATE OF MICHIGAN
MIDLAND COUNTY
REMONUMENTATION & FILED
24 JAN 94 2:53 P.M.
Register of Deeds Stamp & File Number
BEVERLY J THAYER
REGISTER OF DEEDS


I, RODNEY CLAYPOOL, in a field survey on _____, 19__ do hereby certify that under requirements of P.A. 74, Michigan P.A. of 1970, the corner points mentioned on lines 1 and 2 above were in conformance with regulations and rules therefore as required in the current manual of survey instructions of the United States Department of the interior, Bureau of Land Management or by a decree of a Court of Law and/or that the corner points mentioned in lines 3, 4 and 5 above were in conformance with the rules of the Michigan Board of Land Surveyors or by a Decree of a Court of Law; re-established, monumented, re-monumented, recovered, found as expressed below:

	A	B	C	D	E	F	G	H	I	J	K	L	M
2	6	5	4	3	2	1							
3													
4	7	8	9	10	11	12							
5													
6	18	17	16	15	14	13							
7													
8	19	20	21	22	23	24							
9													
10	30	29	28	27	26	25							
11													
12	31	32	33	34	35	36							
13													

NOTE: Not more than 4 corners, all in the same town and range, may be recorded on this certificate.

A. Description of original monument and accessories and/or subsequent restoration:

- D-7 Corner common to Section 17 and 20
 - Wood post Government survey 1830's Survey by M. Hunter 1966, found corner
 - Beech 9", S 12 Deg E, 7 L (4.62') Survey by D. Ledy 1984, found 3/4" pipe
 - Hemlock 6" North 14 L (9.24') South 33' to 3/4" pipe
 - Survey by F. Gibbs 1904, found post SSE 64' to centerline 4" Maple
 - Survey by D. Whittier 1966, set 3/4" pipe ESE 144.80' to nail in power pole
 - Survey by J. Jones 1989 and 1990, found 3/4" pipe

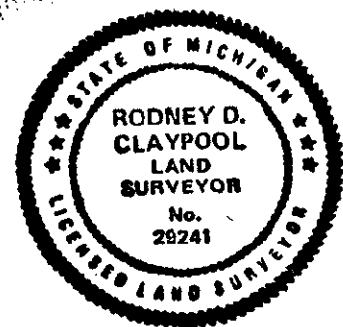

B. Description of corner evidence found and/or method applied in restoring or reestablishing corner:

- D-7 Corner common to Sec. 17 and 20
 - Found 3/4" pipe (top bent, reset by witnesses) as per surveys by F. Gibbs, D. Whittier, M. Hunter, D. Ledy and J. Jones.

Corner D-7 was approved for remonumentation at a Peer-Review Committee Meeting on JAN. 13, 1994.

C. Description of monument for corner and accessories established to perpetuate locating the position of the corner:

- D-7 Corner common to Sec. 17 and 20
 - Found 3/4" pipe (set 3/4" pipe and brass cap stamped Midland Co. Remon Cor. PS 29241 in monument box) per surveys by F. Gibbs, D. Whittier, M. Hunter, D. Ledy and J. Jones and is accepted as the best available evidence of the position of the original corner.
 - S 75 Deg E, 144.80', nail in power pole
 - South 33.0', Ledy iron and cap.
 - S 20 Deg E, 141.24', NW corner brick house
 - S 50 Deg E, 88.0', centerline 10" Maple

Signed by Rodney D. Claypool Date 01-20-94