

SURVEY & REMONUMENTATION

JAN 21 1999

APPROVED LAND CORNER  
P.A. 345 OF 1990  
MIDLAND COUNTY

REMON. COR. D-13, INGERSOLL TWP.  
LAND CORNER RECORDATION CERTIFICATE  
Filing Requirement of Act 74, Mich. P.A. 1970

SECTION  
397

For corners in  
Midland  
(County)

- |                                       |                            |                              |
|---------------------------------------|----------------------------|------------------------------|
| 1. Public Land Survey                 | T <u>13</u> N R <u>2</u> E | Corner Code #<br><u>D-13</u> |
|                                       | T ___ R ___                | _____                        |
|                                       | T ___ R ___                | _____                        |
|                                       | T ___ R ___                | _____                        |
| 2. Property Controlling in Section    | S ___ T ___ R ___          | _____                        |
|                                       | S ___ T ___ R ___          | _____                        |
| 3. Miscellaneous Property in Sec.     | S ___ T ___ R ___          | _____                        |
|                                       | S ___ T ___ R ___          | _____                        |
| 4. Lot No. _____, Recorded Plat _____ |                            |                              |
| 5. Private Claims _____               |                            |                              |

STATE OF MICHIGAN  
MIDLAND COUNTY  
REMONUMENTATION & FILED

12/16/1998 12:11:56 PM

BEVERLY J. THAYER  
REGISTER OF DEEDS

Register of Deeds Stamp & File Number


I, RODNEY CLAYPOOL, in a field survey on APRIL 24, 1997, do hereby certify that under requirements of P.A. 74, Michigan P.A. of 1970, the corner points mentioned on lines 1 and 2 above were in conformance with regulations and rules therefore as required in the current manual of survey instructions of the United States Department of the Interior, Bureau of Land Management or by a decree of a Court of Law and/or that the corner points mentioned in lines 3, 4 and 5 above were in conformance with the rules of the Michigan Board of Land Surveyors or by a Decree of a Court of Law; re-established, monumented, re-monumented, recovered, found as expressed below:

**NOTE:** Not more than 2 corners, all in the same town and range, may be recorded on this certificate.

	A	B	C	D	E	F	G	H	I	J	K	L	M
2	6	5	4	3	2	1							
3													
4	7	8	9	10	11	12							
5													
6	18	17	16	15	14	13							
7													
8	19	20	21	22	23	24							
9													
10	30	29	28	27	26	25							
11													
12	31	32	33	34	35	36							
13													

A. Description of original monument and accessories and/or subsequent restoration:

- D-13 South 1/4 corner, Section 32
- Glo survey, 1830's, set post  
Survey by Hunter and Whittier, 1973, set 3/4" pipe  
Survey by D. Whittier, 1973, found  
Survey by J. Jones, 1990, found pipe  
LCRC by J. Schafer, 1973, set pipe

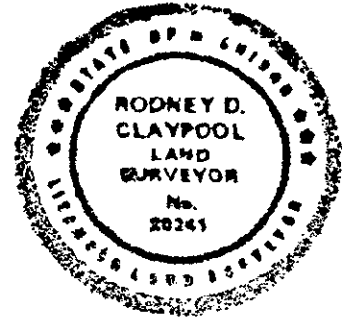

WITNESS NOTE: Witnesses from above surveys and LCRC's are available in dossier file; which was presented to peer review committee and is on file at the Register of Deeds Office.

B. Description of corner evidence found and/or method applied in restoring or reestablishing corner:

- D-13 South 1/4 corner, Section 32
- Found 3/4" pipe per surveys by Hunter and Whittier, D. Whittier, J. Jones, and LCRC by J. Schafer

Corner D-13 was approved for remonumentation at a Peer Review Committee Meeting on August 17, 1998.

C. Description of monument for corner and accessories established to perpetuate locating the position of the corner:

- D-13 South 1/4 corner, Section 32
- Found 3/4" pipe in per survey by Hunter and Whittier, D. Whittier, J. Jones, and LCRC by J. Schafer, replaced pipe with 3/4" pipe and brass cap stamped Midland Co. Remon Cor. PS 29241 and mon box, and is accepted as the best available evidence of the position of the accepted corner.
- S 15 Deg E, 21.9', centerline C.B.  
S 70 Deg E, 205.0', nail and plastic disc in power pole  
N 70 Deg E, 312.14', SW corner barn  
East, 10.55', 3" pipe Saginaw Co. corner

Signed by Rodney D. Claypool

Date 09-11-98

Surveyor's Michigan License No. 29241

Form approved by Michigan State Board of Land Surveyors, Jan. 28, 1971

Revised May 14, 1971

Revised Jan. 1983