

SURVEY &  
REMONUMENTATION

*989 1/13/94*

43

NOV 07 1994

COMMISSION

REMON. COR. E-7, INGERSOLL TWP.  
LAND CORNER RECORDATION CERTIFICATE  
Filing Requirement of Act 74, Mich. P.A. 1970

For corners in  
Midland

(County)

Located in: Corner Code #

- |                                    |   |             |   |           |            |
|------------------------------------|---|-------------|---|-----------|------------|
| 1. Public Land Survey              | T | <u>13</u> N | R | <u>2E</u> | <u>E-7</u> |
|                                    | T | ___         | R | ___       | ___        |
|                                    | T | ___         | R | ___       | ___        |
|                                    | T | ___         | R | ___       | ___        |
| 2. Property Controlling in Section | S | ___         | T | ___       | ___        |
|                                    | S | ___         | T | ___       | ___        |
| 3. Miscellaneous Property in Sec.  | S | ___         | T | ___       | ___        |
|                                    | S | ___         | T | ___       | ___        |

STATE OF MICHIGAN  
MIDLAND COUNTY  
REMONUMENTATION & FILED

24 JAN 94 2:53 P.M.

BEVERLY J THAYER  
REGISTER OF DEEDS

Register of Deeds Stamp & File Number

4. Lot No. \_\_\_\_\_, Recorded Plat \_\_\_\_\_  
5. Private Claims \_\_\_\_\_

A B C D E F G H I J K L M

2	6	5	4	3	2	1
3						
4	7	8	9	10	11	12
5						
6	18	17	16	15	14	13
7						
8	19	20	21	22	23	24
9						
10	30	29	28	27	26	25
11						
12	31	32	33	34	35	36
13						

I, RODNEY CLAYPOOL, in a field survey on DECEMBER, 1993, do hereby certify that under requirements of P.A. 74, Michigan P.A. of 1970, the corner points mentioned on lines 1 and 2 above were in conformance with regulations and rules therefore as required in the current manual of survey instructions of the United States Department of the interior, Bureau of Land Management or by a decree of a Court of Law and/or that the corner points mentioned in lines 3, 4 and 5 above were in conformance with the rules of the Michigan Board of Land Surveyors or by a Decree of a Court of Law; re-established, monumented, re-monumented, recovered, found as expressed below:

**NOTE: Not more than 4 corners, all in the same town and range, may be recorded on this certificate.**

A. Description of original monument and accessories and/or subsequent restoration:

E-7 Corner common to Section 16, 17, 20, 21

Wood post Government survey 1830's  
Hemlock 9", S 81 Deg E, 10 L, (6.6')  
Sycamore 8", N 58 Deg W, 7 1/2 L (4.95")

Survey by J. Schafer 1971 & 78, found mon box  
S 45 Deg W, NW cor store, 46.95'  
S 30 Deg E, nail in power pole, 63.55'  
N 45 Deg W, Centerline Bell Telephone pole box, 40.03'

Survey by F. Gibbs 1900, set stone


Survey by D. Ledy 1984, found 1/2" pipe

Survey by F. Gibbs 1904 found stone

SW 44.70' to cor bldg  
SE 63.49' to nail in power pole  
NW 46.30' to centerline MBT

Survey from Dow, no date, found mon box

Survey by M. Hunter 1967 & 68, found mon box

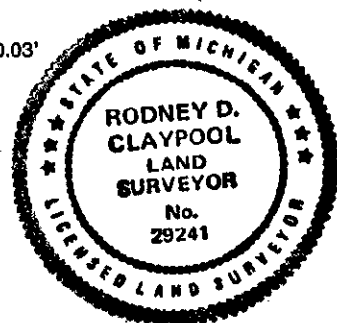

B. Description of corner evidence found and/or method applied in restoring or reestablishing corner:

E-7 Corner common to Sec. 16, 17, 20, 21

Found 1/2" pipe in mon box per surveys by F. Gibbs, M. Hunter, J. Schafer and D. Ledy

Corner E-7 was approved for remonumentation at a Peer Review Committee Meeting on JAN. 13, 1994.

C. Description of monument for corner and accessories established to perpetuate locating the position of the corner:

E-7 Corner common to Sec. 16, 17, 20, 21

Found 1/2" pipe in mon box, removed 1/2" pipe and set 5/8" rod with brass cap stamped Midland Co. Remon Cor. PS 29241 per surveys by F. Gibbs M. Hunter, J. Schafer and D. Ledy and is accepted as the best available evidence of the position of the original corner.

S 45 Deg W, 36.73', NE corner bldg (siding)  
S 40 Deg E, 63.69', nail and plastic disc in power pole  
S 70 Deg E, 116.27', Nail and plastic disc in power pole  
N 15 Deg E, 171.25', Nail and plastic disc in power pole

Signed by Rodney D. Claypool

Date 01-20-94

Surveyor's Michigan License No. 29241