

JAN 21 1999

APPROVED LAND CORNER
P.A. 345 OF 1990
MIDLAND COUNTY

REMON. COR. E-13, INGERSOLL TWP.
LAND CORNER RECORDATION CERTIFICATE
Filing Requirement of Act 74, Mich. P.A. 1970

SECTION

396

For corners in
Midland
(County)

- | | Located in: | Corner Code # |
|---------------------------------------|--------------------------|---------------|
| 1. Public Land Survey | T <u>13N</u> R <u>2E</u> | <u>E-13</u> |
| | T ___ R ___ | _____ |
| | T ___ R ___ | _____ |
| | T ___ R ___ | _____ |
| 2. Property Controlling in Section | S ___ T ___ R ___ | _____ |
| | S ___ T ___ R ___ | _____ |
| 3. Miscellaneous Property in Sec. | S ___ T ___ R ___ | _____ |
| | S ___ T ___ R ___ | _____ |
| 4. Lot No. _____, Recorded Plat _____ | | |
| 5. Private Claims _____ | | |

STATE OF MICHIGAN
MIDLAND COUNTY
REMONUMENTATION & FILED

12/16/1998 12:11:56 PM

BEVERLY J. THAYER
REGISTER OF DEEDS

Register of Deeds Stamp & File Number


I, RODNEY CLAYPOOL, in a field survey on April 24, 1997, do hereby certify that under requirements of P.A. 74, Michigan P.A. of 1970, the corner points mentioned on lines 1 and 2 above were in conformance with regulations and rules therefore as required in the current manual of survey instructions of the United States Department of the Interior, Bureau of Land Management or by a decree of a Court of Law and/or that the corner points mentioned in lines 3, 4 and 5 above were in conformance with the rules of the Michigan Board of Land Surveyors or by a Decree of a Court of Law; re-established, monumented, re-monumented, recovered, found as expressed below:

NOTE: Not more than 2 corners, all in the same town and range, may be recorded on this certificate.

	A	B	C	D	E	F	G	H	I	J	K	L	M
2	6	5	4	3	2	1							
3													
4	7	8	9	10	11	12							
5													
6	18	17	16	15	14	13							
7													
8	19	20	21	22	23	24							
9													
10	30	29	28	27	26	25							
11													
12	31	32	33	34	35	36							
13													

A. Description of original monument and accessories and/or subsequent restoration:

- E-13 Corner common to Sections 32 and 33 on South Townline
- Glo survey, 1830's, set post
 Survey by J. Schafer, 1976, found 3/4" pipe
 Survey and LCRC by D. Hammond, 1978, found 3/4" pipe in mon box
 Survey by J. Jones, 1990, found pipe
 Old survey records, undated, set 3/4" pipe between stone slabs

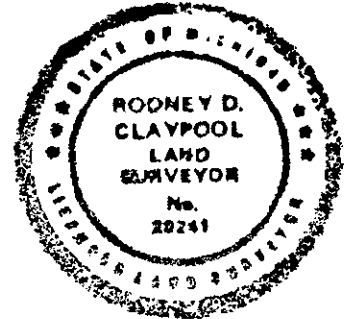

WITNESS NOTE: Witnesses from above surveys and LCRC's are available in dossier file; which was presented to peer review committee and is on file at the Register of Deeds Office.

B. Description of corner evidence found and/or method applied in restoring or reestablishing corner:

- E-13 Corner common to Sections 32 and 33 on South Townline
- Found 3/4" pipe in mon. box per surveys by J. Schafer, D. Hammond, J. Jones, and LCRC by D. Hammond

Corner E-13 was approved for remonumentation at a Peer Review Committee Meeting on August 17, 1998.

C. Description of monument for corner and accessories established to perpetuate locating the position of the corner:

- E-13 Corner common to Sections 32 and 33 on South Townline
- Found 3/4" pipe per surveys by J. Schafer, D. Hammond, J. Jones, and LCRC by D. Hammond, replaced pipe with 5/8" rod and brass cap stamped Midland Co. Remon Cor. PS 29241 in mon box, and is accepted as the best available evidence of the position of the accepted corner.
- S 45 Deg E, 98.45', pk nail in power pole
 N 70 Deg E, 54.14', centerline top telephone box
 N 80 Deg W, 162.86', nail and plastic disc in power pole
 East, 22.60', 3/4" pipe in mon box, Saginaw Co. section corner (Glo 34 Lks)

Signed by Rodney D. Claypool Date 09-11-98