

APPROVED LAND CORNER
P.A. 345 OF 1990
MIDLAND COUNTY

284

LAND CORNER RECORDATION CERTIFICATE
Filing Requirement of Act 74, Mich. P.A. 1970

9/12/96

For corners in

MIDLAND (County)	Located In:	Corner Code #
	T 13N R 2E	G-4
1. Public Land Survey	T _____ R _____	_____
	T _____ R _____	_____
	T _____ R _____	_____
	T _____ R _____	_____
2. Property Controlling in Section	S _____ T _____ R _____	_____
	S _____ T _____ R _____	_____
3. Miscellaneous Property in Sec.	S _____ T _____ R _____	_____
	S _____ T _____ R _____	_____

STATE OF MICHIGAN
MIDLAND COUNTY
REMONUMENTATION & FILED

27 NOV 96 2:54 P.M.

BEVERLY J THAYER
REGISTER OF DEEDS

Register of Deeds Stamp & File Number

4. Lot No. _____, Recorded Plat _____
5. Private Claims _____

I, PAUL B. LAPHAM, in a field survey on DECEMBER 19 95 do hereby state that under requirements of P.A. 74, Michigan P.A. of 1970, the corner points mentioned in lines 1 and 2 above were in conformance with regulations and rules therefore as required in the current manual of survey instructions of the United States Department of the Interior, Bureau of Land Management or by a decree of a Court of Law and/or that the corner points mentioned in lines 3, 4 and 5 above were in conformance with the rules of the Michigan Board of Land Surveyors or by a Decree of a Court of Law, established, re-established, monumented, recovered, found as expressed below:

NOTE: Not more than 2 corners, all in the same town and range, may be recorded on this certificate.

	A	B	C	D	E	F	G	H	I	J	K	L	M
1													
2	6		5		4		3		2		1		
3													
4	7		8		9		10		11		12		
5													
6	18		17		16		15		14		13		
7													
8	19		20		21		22		23		24		
9													
10	30		29		28		27		26		25		
11													
12	31		32		33		34		35		36		
13													

A. Description of original monument and accessories and/or subsequent restoration:

1831 PARKE
SET 1/2 MILE POST
WIT.-MAPLE 30" N73°W 15 LKS.
ELM 12" S76°E 18 1/2 LKS.

1-27-84 MACDONALD (132) 3-540
FOUND IRON & CAP
WIT.-10' NORTH OF E-W DITCH
N.W. 31.9' TO WOOD GATE POST.

6-73 SCHAFER (132) 1-370
NO COR. MATERIAL
13.2' SOUTH OF CENTER-LINE BRIDGE
WIT.-S.E. 8.8' - N.W. COR. CONC. CURB ON BRIDGE
S.W. 9.75' - N.E. COR. CONC. CURB ON BRIDGE

B. Description of corner evidence found and/or method applied in restoring or reestablishing corner:


FOUND 3/4"x12" PIPE 1 FOOT WEST OF CENTER-LINE ASPHALT. CORNER IS 10 FEET NORTH OF CENTER-LINE OF NEW DRAINAGE PIPE THAT REPLACED BRIDGE. MEASURED SOUTH 2653.38' (SCHAFER 2653.08') TO G-5. MEASURED NORTH 2600.70' TO G-3. MEASURED NORTH 2704.80' (GIBBS 2705.34', LEDY 2704.50', MCDONALD 2704.6', GLO 2640.0') FROM G-3 TO G-2. (SEE G-3 FILE FOR DOCUMENTATIONS). AYRES FILES STATE THAT CORNER IS 13.2 FEET NORTH OF BRIDGE.

Corner, G-4 was approved for remonumentation at a Peer Review Committee Meeting on SEP. 12, 1996.

C. Description of monument for corner and accessories established to perpetuate locating the position of the corner:

SET 3/4"x18" GAS PIPE WITH BRASS CAP STAMPED "MIDLAND CO. REMON. COR. P.S. 9433" IN MON. BOX. ACCEPTED AS BEST AVAILABLE EVIDENCE OF THE ACCEPTED POSITION OF THE CORNER.

WITNESSES:
N60°E, 27.42' - NAIL & TAG IN TOP OF GUARD RAIL POST
S35°E, 42.17' - NAIL & TAG IN TOP OF GUARD RAIL POST
S24°W, 44.30' - NAIL & TAG IN TOP OF GUARD RAIL POST
N65°W, 20.04' - NAIL & TAG IN TOP OF GUARD RAIL POST

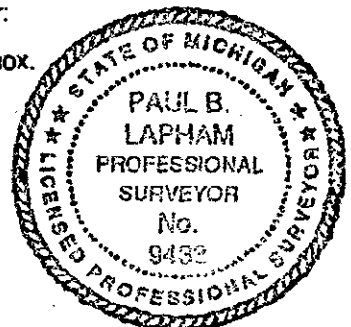

Signed by Paul B. Lapham
Surveyor's Michigan License No. 9433

Date 10-9-96