

APPROVED LAND CORNER  
P.A. 345 OF 1990  
MIDLAND COUNTY

SURVEY &  
REMONUMENTATION

REMON. COR. H-5, INGERSOLL TWP  
LAND CORNER RECORDATION CERTIFICATE  
Filing Requirement of Act 74, Mich. P.A. 1970

FEB 24 1998

SECTION 320

For corners in  
Midland  
(County)

- |                                       |                          |            |
|---------------------------------------|--------------------------|------------|
| 1. Public Land Survey                 | T <u>13N</u> R <u>2E</u> | <u>H-5</u> |
|                                       | T ___ R ___              | _____      |
|                                       | T ___ R ___              | _____      |
|                                       | T ___ R ___              | _____      |
| 2. Property Controlling<br>in Section | S ___ T ___ R ___        | _____      |
|                                       | S ___ T ___ R ___        | _____      |
| 3. Miscellaneous<br>Property in Sec.  | S ___ T ___ R ___        | _____      |
|                                       | S ___ T ___ R ___        | _____      |
| 4. Lot No. _____, Recorded Plat _____ |                          |            |
| 5. Private Claims _____               |                          |            |

STATE OF MICHIGAN  
MIDLAND COUNTY  
REMONUMENTATION & FILED

8 DEC 97 11:03 A.M.

BEVERLY J THAYER  
REGISTER OF DEEDS

Register of Deeds Stamp & File Number


I, RODNEY CLAYPOOL, in a field survey on Apr 8, 1996, do hereby certify that under requirements of P.A. 74, Michigan P.A. of 1970, the corner points mentioned on lines 1 and 2 above were in conformance with regulations and rules therefore as required in the current manual of survey instructions of the United States Department of the Interior, Bureau of Land Management or by a decree of a Court of Law and/or that the corner points mentioned in lines 3, 4 and 5 above were in conformance with the rules of the Michigan Board of Land Surveyors or by a Decree of a Court of Law; re-established, monumented, re-monumented, recovered, found as expressed below:

**NOTE: Not more than 2 corners, all in the same town and range, may be recorded on this certificate.**

	A	B	C	D	E	F	G	H	I	J	K	L	M
2	6	5	4	3	2	1							
3													
4	7	8	9	10	11	12							
5													
6	18	17	16	15	14	13							
7													
8	19	20	21	22	23	24							
9													
10	30	29	28	27	26	25							
11													
12	31	32	33	34	35	36							
13													

A. Description of original monument and accessories and/or subsequent restoration:

- H-5 Corner common to Sections 10 and 15
- 1831, Government survey by H. Parke, set corner
  - 1952, Dow survey of Sec 10 by Hunter, 1/2" rod
  - 1952, Dow survey of Sec 15 by Hunter, 1/2" rod
  - 1975, Survey of Sec 10 by H-W, no drawing, found 1/2" shaft, raised with 2 ft of 3/4" pipe
  - 1984, rec survey by MacDonald, L-003, P-536, found 3/4" pipe

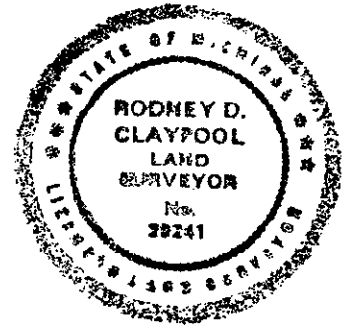

WITNESS NOTE: Witnesses from above surveys and LCRC's are available in dossier file; which was presented to peer review committee and is on file at the Register of Deeds Office.

B. Description of corner evidence found and/or method applied in restoring or reestablishing corner:

- H-5 Corner common to Sections 10 and 15
- Found 3/4" pipe on 1/2" rod 3 ft long (top bent reset) per surveys by M. Hunter, H-W, and M. MacDonald

Corner H-5 was approved for remonumentation at a Peer Review Committee Meeting on August 8, 1997.

C. Description of monument for corner and accessories established to perpetuate locating the position of the corner:

- H-5 Corner common to Sections 10 and 15
- Found 3/4" pipe on 1/2" rod, replaced with 3/4" pipe and brass cap stamped Midland Co. Remon Cor. PS 29241, per surveys by Hunter, H-W, and M. MacDonald; and is accepted as the best available evidence of the position of the accepted corner.
- S 5 Deg E, 28.80', notch in East end 12" CMP (R)
  - S 20 Deg W, 35.68', chiseled "+" in West end 12" CMP
  - N 65 Deg W, 46.96', notch in North end 12" CMP (R)
  - N 70 Deg W, 111.43', nail and plastic disc in power pole
  - N 80 Deg E, 200.22, nail and plastic disc in power pole
  - North, 0.5', North edge bit road (R)

Signed by Rodney D Claypool Date 11-26-97

Surveyor's Michigan License No. 29241