

APPROVED LAND CORNER
P.A. 345 OF 1990
MIDLAND COUNTY

SURVEY &
REMONUMENTATION

REMON. COR. I-4, INGERSOLL TWP FEB 24 1998
LAND CORNER RECORDATION CERTIFICATE
Filing Requirement of Act 74, Mich. P.A. 1970

SECTION 322

For corners in
Midland

(County)	Located in:	Corner Code #
1. Public Land Survey	T <u>13N</u> R <u>2E</u>	<u>I-4</u>
	T ___ R ___	_____
	T ___ R ___	_____
	T ___ R ___	_____
2. Property Controlling in Section	S ___ T ___ R ___	_____
	S ___ T ___ R ___	_____
3. Miscellaneous Property in Sec.	S ___ T ___ R ___	_____
	S ___ T ___ R ___	_____
4. Lot No. _____, Recorded Plat _____		
5. Private Claims _____		

STATE OF MICHIGAN
MIDLAND COUNTY
REMONUMENTATION & FILED

8 DEC 97 11:04 A.M.

BEVERLY J THAYER
REGISTER OF DEEDS
Register of Deeds Stamp & File Number


I, RODNEY CLAYPOOL, in a field survey on March 28, 1996, do hereby certify that under requirements of P.A. 74, Michigan P.A. of 1970, the corner points mentioned on lines 1 and 2 above were in conformance with regulations and rules therefore as required in the current manual of survey instructions of the United States Department of the Interior, Bureau of Land Management or by a decree of a Court of Law and/or that the corner points mentioned in lines 3, 4 and 5 above were in conformance with the rules of the Michigan Board of Land Surveyors or by a Decree of a Court of Law; re-established, monumented, re-monumented, recovered, found as expressed below:

NOTE: Not more than 2 corners, all in the same town and range, may be recorded on this certificate.

	A	B	C	D	E	F	G	H	I	J	K	L	M
2	6	5	4	3	2	1							
3													
4	7	8	9	10	11	12							
5													
6	18	17	16	15	14	13							
7													
8	19	20	21	22	23	24							
9													
10	30	29	28	27	26	25							
11													
12	31	32	33	34	35	36							
13													

A. Description of original monument and accessories and/or subsequent restoration:

- I-4 Corner common to Sections 10 and 11
- 1831, Government survey by H. Parke, set corner
- 1952, Dow survey by Hunter, 3/4" iron pipe
- 1979, rec survey by Hunter, L-2, P-856, found 3/4" pipe
- 1986, rec survey by Ledy, L-3, P-995, found 3/4" pipe with cap
- 1987, two rec surveys by Ledy, L-4, P-129 and L-4, P-143, found 3/4" pipe raised to surface with 1 1/2" pipe
- 1988, LCRC #641 by Ledy, found 3/4" pipe, 2 ft deep, raised with 3/4" pipe
- 1994, rec survey by Jones, L-5, P-228, found 3/4" pipe, 3" deep

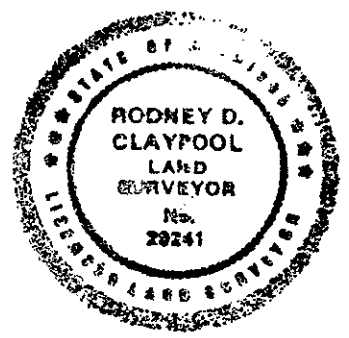

WITNESS NOTE: Witnesses from above surveys and LCRC's are available in dossier file; which was presented to peer review committee and is on file at the Register of Deeds Office.

B. Description of corner evidence found and/or method applied in restoring or reestablishing corner:

- I-4 Corner common to Sections 10 and 11
- Found 3/4" pipe per surveys by M. Hunter, D. Ledy, J. Jones, and LCRC by D. Ledy

Corner I-4 was approved for remonumentation at a Peer Review Committee Meeting on August 8, 1997.

C. Description of monument for corner and accessories established to perpetuate locating the position of the corner:

- I-4 Corner common to Sections 10 and 11
- Found 3/4" pipe, replaced with 3/4" pipe with brass cap stamped Midland Co. Remon Cor. PS 29241 in mon box, per surveys by M. Hunter, D. Ledy, J. Jones, and LCRC by D. Ledy; and is accepted as the best available evidence of the position of the accepted corner.
- S 40 Deg W, 97.35', nail and tag in power pole
- N 70 Deg W, 92.94', nail and tag in power pole
- N 30 Deg W, 74.35', NE corner telephone box (cleaning)
- N 45 Deg W, 152.15', SE cor (block) house
- N 20 Deg E, 230.30', nail and plastic disc in power pole
- West, 4.0', centerline road

Signed by Rodney D. Claypool

Date 11-26-97

Surveyor's Michigan License No. 29241