

APPROVED LAND CORNER
P.A. 345 OF 1990
MIDLAND COUNTY

SURVEY &
REMONUMENTATION

FEB 24 1998

REMON. COR. I-6, INGERSOLL TWP
LAND CORNER RECORDATION CERTIFICATE
Filing Requirement of Act 74, Mich. P.A. 1970 SECTION

For corners in
Midland
(County)

Located in: Corner Code #
T 13N R 2E I-6
T R
T R
T R
S T R
S T R
S T R
S T R

324

STATE OF MICHIGAN
MIDLAND COUNTY
REMONUMENTATION & FILED

8 DEC 97 11:04 A.M.

Register of Deeds Stamp & File Number
BEVERLY J THAYER
REGISTER OF DEEDS

1. Public Land Survey

2. Property Controlling
in Section

3. Miscellaneous
Property in Sec.

4. Lot No. _____, Recorded Plat _____

5. Private Claims _____

I, RODNEY CLAYPOOL, in a field survey on Apr 8, 1996, do hereby certify that under requirements of P.A. 74, Michigan P.A. of 1970, the corner points mentioned on lines 1 and 2 above were in conformance with regulations and rules therefore as required in the current manual of survey instructions of the United States Department of the interior, Bureau of Land Management or by a decree of a Court of Law and/or that the corner points mentioned in lines 3, 4 and 5 above were in conformance with the rules of the Michigan Board of Land Surveyors or by a Decree of a Court of Law; re-established, monumented, re-monumented, recovered, found as expressed below:

NOTE: Not more than 2 corners, all in the same town and range, may be recorded on this certificate.

A B C D E F G H I J K L M


2	6	5	4	3	2	1
3						
4	7	8	9	10	11	12
5						
6	18	17	16	15	14	13
7						
8	19	20	21	22	23	24
9						
10	30	29	28	27	26	25
11						
12	31	32	33	34	35	36
13						

A. Description of original monument and accessories and/or subsequent restoration:

I-6 Corner common to Sections 14 and 15

- 1831, Government survey by H. Parke, set corner
- 1952, Dow survey by Hunter, 3" iron pipe
- 1968, survey by Hunter, 3" iron pipe
- 1979, LCRC #488 by Schafer, 2" pipe
- 1979, rec survey by Schafer, found 2" pipe

WITNESS NOTE: Witnesses from above surveys and LCRC's are available in dossier file; which was presented to peer review committee and is on file at the Register of Deeds Office.

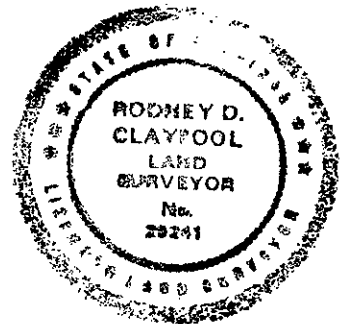

B. Description of corner evidence found and/or method applied in restoring or reestablishing corner:

I-6 Corner common to Sections 14 and 15

Found 3" pipe with 1/2" rod in center per surveys by M. Hunter, J. Schafer and LCRC by J. Schafer

Corner I-6 was approved for remonumentation at a Peer Review Committee Meeting on August 8, 1997.

C. Description of monument for corner and accessories established to perpetuate locating the position of the corner:

I-6 Corner common to Sections 14 and 15

Found 3" pipe with 1/2" rod in center, replaced with 3/4" pipe and brass cap stamped Midland Co. Remon Cor. PS 29241, per surveys by M. Hunter, J. Schafer and LCRC by J. Schafer; and is accepted as the best available evidence of the position of the accepted corner.

- S 85 Deg E, 35.71', nail and tag in power pole (R)
- N 45 Deg E, 28.62', W'y high point on pink rock (R)
- N 85 Deg W, 33.97', centerline of W'y pipe line marker (R)
- N 20 Deg E, 44.75', SW corner concrete drive (East of driveway approach)
- East 0.6', centerline road

Signed by Rodney D. Claypool Date 11-26-97

Surveyor's Michigan License No. 29241

Form approved by Michigan State Board of Land Surveyors, Jan. 28, 1971

Revised May 14, 1971

Revised Jan., 1983