

NOV 07 1994

9-19 1/13/94

50

COMMISSION

REMON. COR. I-11 INGERSOLL TWP.
LAND CORNER RECORDATION CERTIFICATE
Filing Requirement of Act 74, Mich. P.A. 1970

For corners in
Midland

(County)	Located in:	Corner Code #
1. Public Land Survey	T <u>13N</u> R <u>2E</u>	<u>I-11</u>
	T ___ R ___	_____
	T ___ R ___	_____
	T ___ R ___	_____
2. Property Controlling in Section	S ___ T ___ R ___	_____
	S ___ T ___ R ___	_____
3. Miscellaneous Property in Sec.	S ___ T ___ R ___	_____
	S ___ T ___ R ___	_____
4. Lot No. _____, Recorded Plat _____		
5. Private Claims _____		

STATE OF MICHIGAN
MIDLAND COUNTY
REMONUMENTATION & FILED

24 JAN 94 2:54 P.M.

BEVERLY J THAYER
REGISTER OF DEEDS

Register of Deeds Stamp & File Number


I, RODNEY CLAYPOOL, in a field survey on DECEMBER, 1993, do hereby certify that under requirements of P.A. 74, Michigan P.A. of 1970, the corner points mentioned on lines 1 and 2 above were in conformance with regulations and rules therefore as required in the current manual of survey instructions of the United States Department of the Interior, Bureau of Land Management or by a decree of a Court of Law and/or that the corner points mentioned in lines 3, 4 and 5 above were in conformance with the rules of the Michigan Board of Land Surveyors or by a Decree of a Court of Law; re-established, monumented, re-monumented, recovered, found as expressed below:

	A	B	C	D	E	F	G	H	I	J	K	L	M
2	6	5	4	3	2	1							
3													
4	7	8	9	10	11	12							
5													
6	18	17	16	15	14	13							
7													
8	19	20	21	22	23	24							
9													
10	30	29	28	27	26	25							
11													
12	31	32	33	34	35	36							
13													

NOTE: Not more than 4 corners, all in the same town and range, may be recorded on this certificate.

A. Description of original monument and accessories and/or subsequent restoration:

I-11	Corner common to Section 26, 27, 34, 35 Wood post Government survey 1830's Sycamore 8", S 25 Deg W, 5 L, (3.30') Hickory 6", N 32 Deg E, 2 L (1.32') Survey by Consumers Power Co., found 3/4" Pipe Power pole NW 49.29' Telephone pole SE 48.10' Road sign NE 48.0' Survey by D. Whittier 1971, 1972, found corner Survey by J. Schafer 1978, found corner N 55 Deg E, nail in S. pole tower line 160.00' N 50 Deg W, 1' steel fence post 49.55' East nail in power pole 120.45' Survey by J. Schafer 1979, found corner Survey by M. MacDonald 1984, found corner NW 49.4' to utility pole SW 63.5' to N end 15" CMP	Survey by J. Schafer 1986, found 3/4" pipe Survey by J. Jones 1992, found 3/4" pipe in mon box S 45 Deg, E, PK nail in telephone stub 48.30' N 45 Deg, W, PK nail in power pole 62.46' N 10 Deg, E, SE cor bridge G.R. 84.02' N 10 Deg, W, SW cor bridge G.R. 72.03' North 1' centerline road LCRC by L. McGinnis 1977, 3/8" rod 49.2' NW to tag power pole 42.8' NE to road sign post 48.0 SE to telephone pole LCRC by D. Whittier 1977, found 3/4" pipe S 45 Deg, E, Nail in telephone pole 48.12' N 45 Deg W, nail and disc 49.37' on line with west guardrail of bridge to North Old witness (no date) found stone put iron around
------	--	--

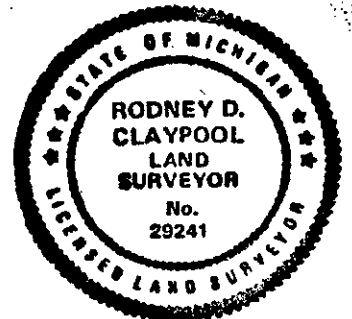

B. Description of corner evidence found and/or method applied in restoring or reestablishing corner:

I-11 Corner common to Sec. 26, 27, 34, 35
Found 3/4" pipe in mon box per survey by Consumers Power Co., D. Whittier, J. Schafer, M. MacDonald and J. Jones and LCRC by L. McGinnis and D. Whittier

Corner I-11 was approved for remonumentation at a Peer Review Committee Meeting on JAN. 13, 1994.

C. Description of monument for corner and accessories established to perpetuate locating the position of the corner:

I-11	Corner common to Sec. 26, 27, 34, 35 Found 3/4" pipe in mon box (set 3/4" pipe with brass cap stamped Midland Co. Remon Cor. PS 29241) per surveys by Consumers Power Co., D. Whittier, J. Schafer, M. MacDonald, J. Jones and LCRCs by L. McGinnis and D. Whittier and is accepted as the best available evidence of the position of the original corner. S 45 Deg E, 48.29', nail and plastic disc in telephone pole stub N 60 Deg E, 89.85', nail and plastic disc in Easterly guardrail post	N 10 Deg E, 84.15', "+" in top S. end concrete barrier wall N 45 Deg W, 62.47', nail and plastic disc in power pole
------	---	--

Signed by Rodney D. Claypool Date 01-20-94