

J.P.J. 1/13/94
40

REMONUMENTATION
NOV 07 1994
COMMISSION

REMON. COR. J-7, INGERSOLL TWP.
LAND CORNER RECORDATION CERTIFICATE
Filing Requirement of Act 74, Mich. P.A. 1970

For corners in
Midland

(County)	Located in:	Corner Code #
1. Public Land Survey	T 13N R 2E	J-7
	T ___ R ___	_____
	T ___ R ___	_____
	T ___ R ___	_____
2. Property Controlling in Section	S ___ T ___ R ___	_____
	S ___ T ___ R ___	_____
3. Miscellaneous Property in Sec.	S ___ T ___ R ___	_____
	S ___ T ___ R ___	_____
4. Lot No. _____, Recorded Plat _____		
5. Private Claims _____		

STATE OF MICHIGAN
MIDLAND COUNTY
REMONUMENTATION & FILED

24 JAN 94 2:53 P.M.

Register of Deeds Stamp & File Number
BEVERLY J. THAYER
REGISTER OF DEEDS

I, RODNEY CLAYPOOL, in a field survey on DECEMBER, 1993, do hereby certify that under requirements of P.A. 74, Michigan P.A. of 1970, the corner points mentioned on lines 1 and 2 above were in conformance with regulations and rules therefore as required in the current manual of survey instructions of the United States Department of the Interior, Bureau of Land Management or by a decree of a Court of Law and/or that the corner points mentioned in lines 3, 4 and 5 above were in conformance with the rules of the Michigan Board of Land Surveyors or by a Decree of a Court of Law; re-established, monumented, re-monumented, recovered, found as expressed below:

	A	B	C	D	E	F	G	H	I	J	K	L	M
2	6	5	4	3	2	1							
3													
4	7	8	9	10	11	12							
5													
6	18	17	16	15	14	13							
7													
8	19	20	21	22	23	24							
9													
10	30	29	28	27	26	25							
11													
12	31	32	33	34	35	36							
13													

NOTE: Not more than 4 corners, all in the same town and range, may be recorded on this certificate.

A. Description of original monument and accessories and/or subsequent restoration:

J-7 Corner common to Section 14 and 23


Wood post Government survey 1830's

Survey by D. Whittier 1968, found 1" pipe

Elm 30", S 63 1/2 Deg E, 40 L, (26.40')
Maple 28", S 21 Deg W, 18 L (11.88')

Survey by W. Ruddell 1973, found iron pipe in pavement

Survey by D. Whittier 1964,
found 1 3/4" x 3/4" iron raised with 1" pipe

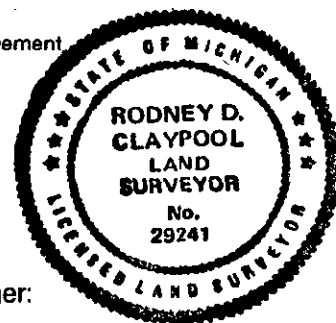

B. Description of corner evidence found and/or method applied in restoring or reestablishing corner:

J-7 Corner common to Section 14 and 23

Found 3/4" pipe 2' deep per survey by D. Whittier and W. Ruddell

Corner J-7 was approved for remonumentation at a Peer Review Committee Meeting on JAN 13, 1994.

C. Description of monument for corner and accessories established to perpetuate locating the position of the corner:

J-7 Corner common to Section 14 and 23

Found 3/4" pipe 2' deep (raised with 3/4" pipe and brass cap stamped Midland Co. Remon Cor. PS 29241 in monument box) per surveys by D. Whittier and W. Ruddell and is accepted as the best available evidence of the position of the original corner.

N 45 Deg, E 48.93', nail and plastic disc in power pole
S 10 Deg, E 28.50', nail and plastic disc in power pole
N 30 Deg, W 49.85' centerline 48" CMP
S 20 Deg, W 30.15', centerline 48" CMP

Signed by Rodney D. Claypool Date 01-20-94