

APPROVED LAND CORNER  
P.A. 345 OF 1990  
MIDLAND COUNTY

SURVEY &  
REMONUMENTATION

REMON. COR. K-5, INGERSOLL TWP  
LAND CORNER RECORDATION CERTIFICATE  
Filing Requirement of Act 74, Mich. P.A. 1970

FEB 24 1998

SECTION 325

For corners in  
Midland  
(County)

- |                                       |                          |            |
|---------------------------------------|--------------------------|------------|
| 1. Public Land Survey                 | T <u>13N</u> R <u>2E</u> | <u>K-5</u> |
|                                       | T ___ R ___              | _____      |
|                                       | T ___ R ___              | _____      |
|                                       | T ___ R ___              | _____      |
| 2. Property Controlling in Section    | S ___ T ___ R ___        | _____      |
|                                       | S ___ T ___ R ___        | _____      |
| 3. Miscellaneous Property in Sec.     | S ___ T ___ R ___        | _____      |
|                                       | S ___ T ___ R ___        | _____      |
| 4. Lot No. _____, Recorded Plat _____ |                          |            |
| 5. Private Claims _____               |                          |            |

STATE OF MICHIGAN  
MIDLAND COUNTY  
REMONUMENTATION & FILED

8 DEC 97 11:04 A.M.

Register of Deeds Stamp & File Number  
BEVERLY J. THAYER  
REGISTER OF DEEDS


I, RODNEY CLAYPOOL, in a field survey on March 28, 1996, do hereby certify that under requirements of P.A. 74, Michigan P.A. of 1970, the corner points mentioned on lines 1 and 2 above were in conformance with regulations and rules therefore as required in the current manual of survey instructions of the United States Department of the Interior, Bureau of Land Management or by a decree of a Court of Law and/or that the corner points mentioned in lines 3, 4 and 5 above were in conformance with the rules of the Michigan Board of Land Surveyors or by a Decree of a Court of Law; re-established, monumented, re-monumented, recovered, found as expressed below:

NOTE: Not more than 2 corners, all in the same town and range, may be recorded on this certificate.

	A	B	C	D	E	F	G	H	I	J	K	L	M
2	6	5	4	3	2	1							
3													
4	7	8	9	10	11	12							
5													
6	18	17	16	15	14	13							
7													
8	19	20	21	22	23	24							
9													
10	30	29	28	27	26	25							
11													
12	31	32	33	34	35	36							
13													

A. Description of original monument and accessories and/or subsequent restoration:

- K-5 Corner common to Sections 11, 12, 13 and 14
- 1831, Government survey by H. Parke, set corner
  - No date, H-W witness card, found 1" iron pipe
  - 1955, survey by Hunter, found corner
  - 1964, survey by Hunter, no call
  - 1973, rec survey by Schafer, L-1, P-274, mon box
  - 1975, rec survey by Schafer, L-1, P-827, mon box
  - 1979, rec survey by Schafer, L-2, P-826, found 1" pipe in mon box

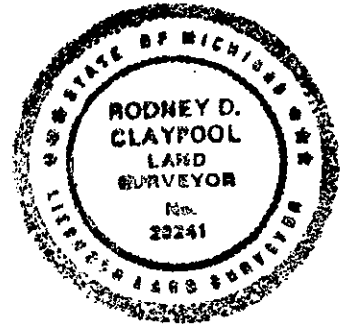

WITNESS NOTE: Witnesses from above surveys and LCRC's are available in dossier file; which was presented to peer review committee and is on file at the Register of Deeds Office.

B. Description of corner evidence found and/or method applied in restoring or reestablishing corner:

- K-5 Corner common to Sections 11, 12, 13 and 14
- Found 3/4" pipe in mon box per surveys by M. Hunter, D. Whittier, J. Schafer, and M. Hunter witness card (no date)

Corner K-5 was approved for remonumentation at a Peer Review Committee Meeting on August 8, 1997.

C. Description of monument for corner and accessories established to perpetuate locating the position of the corner:

- K-5 Corner common to Sections 11, 12, 13 and 14
- Found 3/4" pipe in mon box, replaced pipe with 3/4" pipe and brass cap stamped Midland Co. Remon Cor. PS 29241, per surveys by M. Hunter, D. Whittier, J. Schafer, and M. Hunter witness card (no date)
- S 45 Deg E, 46.21', nail in telephone pole stub (R)
  - N 50 Deg E, 48.10', N rivet on E end 48" CMP
  - S 45 Deg W, 57.60', pk nail in power pole (R)
  - N 45 Deg W, 75.55', pk nail in power pole
  - South, 4.0', centerline E and W road

Signed by Rodney D. Claypool Date 11-26-97

Surveyor's Michigan License No. 29241