

JAN 21 1999

APPROVED LAND CORNER
P.A. 345 OF 1990
MIDLAND COUNTY

REMON. COR. M-12, INGERSOLL TWP.
LAND CORNER RECORDATION CERTIFICATE
Filing Requirement of Act 74, Mich. P.A. 1970

SECTION

394

For corners in
Midland
(County)

Located in:	Corner Code #
T 13N R 2E	M-12
T ___ R ___	_____
T ___ R ___	_____
T ___ R ___	_____
S ___ T ___ R ___	_____
S ___ T ___ R ___	_____
S ___ T ___ R ___	_____
S ___ T ___ R ___	_____

STATE OF MICHIGAN
MIDLAND COUNTY
REMONUMENTATION & FILED

12/16/1998 12:11:56 PM

BEVERLY J. THAYER
REGISTER OF DEEDS

Register of Deeds Stamp & File Number

1. Public Land Survey

2. Property Controlling
in Section

3. Miscellaneous
Property in Sec.

4. Lot No. _____, Recorded Plat _____

5. Private Claims _____

A B C D E F G H I J K L M

2	6	5	4	3	2	1
3						
4	7	8	9	10	11	12
5						
6	18	17	16	15	14	13
7						
8	19	20	21	22	23	24
9						
10	30	29	28	27	26	25
11						
12	31	32	33	34	35	36
13						

I, RODNEY CLAYPOOL, in a field survey on APRIL 25, 1997, do hereby certify that under requirements of P.A. 74, Michigan P.A. of 1970, the corner points mentioned on lines 1 and 2 above were in conformance with regulations and rules therefore as required in the current manual of survey instructions of the United States Department of the interior, Bureau of Land Management or by a decree of a Court of Law and/or that the corner points mentioned in lines 3, 4 and 5 above were in conformance with the rules of the Michigan Board of Land Surveyors or by a Decree of a Court of Law; re-established, monumented, re-monumented, recovered, found as expressed below:


NOTE: Not more than 2 corners, all in the same town and range, may be recorded on this certificate.

A. Description of original monument and accessories and/or subsequent restoration:

M-12 East 1/4 corner, Section 36, T13N-R2E and West 1/4, Section 31, T13N-R3E

Glo survey, 1830's, set post
Survey by D. Whittier, 1968, found 1" pipe

WITNESS NOTE: Witnesses from above surveys and LCRC's are available in dossier file; which was presented to peer review committee and is on file at the Register of Deeds Office.

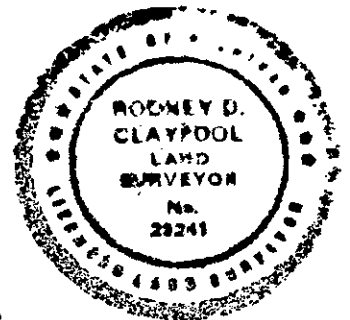

B. Description of corner evidence found and/or method applied in restoring or reestablishing corner:

M-12 East 1/4 corner, Section 36, T13N-R2E and West 1/4 corner, Section 31, T13N-R3E

Found 1/2" rod (2' long) with cap per survey by D. Whittier

Corner M-12 was approved for remonumentation at a Peer Review Committee Meeting on August 17, 1998.

C. Description of monument for corner and accessories established to perpetuate locating the position of the corner:

M-12 East 1/4 corner, Section 36, T13N-R2E and West 1/4 corner, Section 31, T13N-R2E

Found 1/2" rod with cap per survey by D. Whittier, replaced rod with 5/8" rod and brass cap stamped Midland Co. Remon Cor. PS 29241 in mon box, and is accepted as the occupied evidence of the position of the corner.

- N 85 Deg E, 56.13', nail and plastic disc in 6" Crab Apple
- N 85 Deg W, 33.70', nail in 6" Cherry
- N 84 Deg W, 39.50', nail and plastic disc in 10" Ash
- East, 32.88', iron with Ledy cap
- N 40 Deg W, 79.15', nail and disc in power pole

Signed by Rodney D. Claypool

Date 09-11-98

Surveyor's Michigan License No. 29241