


# LAND CORNER RECORDATION CERTIFICATE


Filing Requirement of Act 74, Mich. PA 1970

For Corners In: <u>Midland</u> (County)	Located In	Corner Code #
1. Public Land Survey	T <u>13N</u> R <u>2W</u>	<u>M9</u>
	T <u>13N</u> R <u>1W</u>	<u>A9</u>
2. Property Controlling in Section	S _____ T _____ R _____	_____
	S _____ T _____ R _____	_____
3. Miscellaneous Property in Section	S _____ T _____ R _____	_____
	S _____ T _____ R _____	_____
4. Lot No: _____	Recorded Plat: _____	
5. Private Claims: _____		

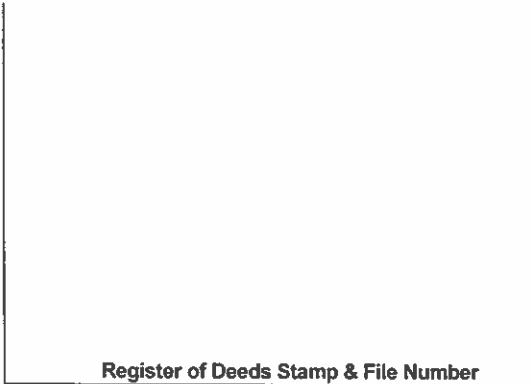

I, Craig W. McVean, in a field survey on July 21, 2010 do hereby state that under requirements of PA 74, Michigan PA of 1970, the corner points mentioned in lines 1 and 2 above were in conformance with regulations and rules therefore as required in the current manual of survey instructions of the United States Department of the Interior, Bureau of Land Management or by a decree of a Court of Law and/or that the corner points mentioned in lines 3, 4 and 5 above were in conformance with the rules of the Michigan Board of Land Surveyors or by a Decree of a Court of Law, established, re-established, monumented, recovered, found as expressed below:

**NOTE: Not more than 2 corners, all in the same town and range, may be recorded on this certificate.**

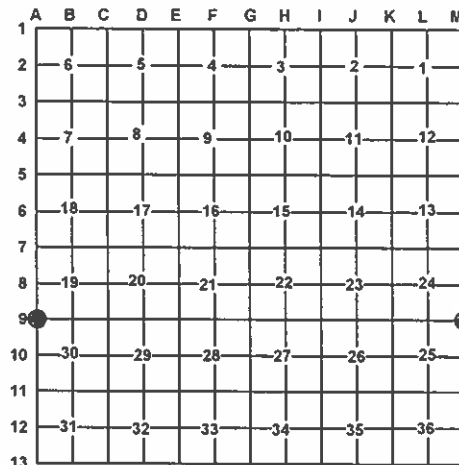

**A. Description of original monument and accessories and/or subsequent restoration:**

- M9-A9 -- 1831 -- Post -- R. Clark, Jr.  
 1) Hemlock 16" S74°W 21 L.; 2) Hemlock 11" N30°W 21 L.  
 - 1898 -- CSR, p. 28 -- F. J. Gibbs. Sec. 30, T13N, R1W Survey -- Set Post Corner to 19 & 30.  
 - 1900 -- CSR -- L. 1, p. 10 -- F. J. Gibbs -- Sec. 19, T13N, R1W -- Set W. Oak post  
 - 1904 -- CSR -- L. 1, p. 37 -- F. J. Gibbs -- Sec. 24, T13N, R2W -- Old post standing  
 - 1972 -- Rec. Survey -- L. 1, p. 264 & Field Notes -- D. B. Whittier -- Fd. 1/2" pipe (Notes say "Fd. NE Cor.")

**B. Description of corner evidence found and/or method applied in restoring or re-establishing corner:**

M9-A9 -- Standard Corner common to Sec. 24 & 25, T13N, R2W and Section 19 & 30, T13N, R1W -- Fd. 5/8" I.D. (1" O.D.) iron pipe -- Down 1.5'. Centerline of N-S Gravel road is 7'± East. Remains of down woven wire fence goes East from pipe. Measured North 201' to S. Bank of drain (GLO calls for 165' to "Brook 25 NE"). No GLO evidence. 5/8" I.D. iron pipe accepted as the best available evidence of the position of the original corner.

**C. Description of monument for corner and accessories established to perpetuate locating the position of the corner:**

- M9-A9 -- 5/8" I.D. iron pipe  
 N02°E 65.99' to Fd. 1/2" capped iron #39074  
 N23°E 52.85' to set N & T in Top center guard rail post  
 S83°E 63.68' to set N & T in side of Power Pole  
 S22°E 57.45' to Fd. nail & tag in W. side 28" Oak



Signed by: Craig W. McVean Date: 11/18/2010  
 Surveyor's Michigan License No.: 39088