

APPROVED LAND CORNER
P.A. 345 OF 1990
MIDLAND COUNTY

REGISTERED PROFESSIONAL SURVEYOR

6/15/95 gld

LAND CORNER RECORDATION CERTIFICATE
Filing Requirement of Act 74, Mich. P.A. 1970

For corners in

<u>MIDLAND</u> (County)	Located In:	Corner Code #
1. Public Land Survey	T <u>13N</u> R <u>2W</u>	<u>G-8</u>
	T _____ R _____	_____
	T _____ R _____	_____
	T _____ R _____	_____
2. Property Controlling in Section	S _____ T _____ R _____	_____
	S _____ T _____ R _____	_____
3. Miscellaneous Property in Sec.	S _____ T _____ R _____	_____
	S _____ T _____ R _____	_____

218
STATE OF MICHIGAN
MIDLAND COUNTY
FILED

19 JUL 95 10:52 A.M.

BEVERLY J THAYER
REGISTER OF DEEDS

Register of Deeds Stamp & File Number

4. Lot No. _____, Recorded Plat _____
5. Private Claims _____

	A	B	C	D	E	F	G	H	I	J	K	L
2	6	5	4	3	2	1						
3												
4	7	8	9	10	11	12						
5												
6	18	17	16	15	14	13						
7												
8	19	20	21	22	23	24						
9												
10	30	29	28	27	26	25						
11												
12	31	32	33	34	35	36						
13												

I, PAUL B. LAPHAM, in a field survey on MAY, 19 95, do hereby certify that under requirements of P.A. 74, Michigan P.A. of 1970, the corner points mentioned in lines 1 and 2 above were in conformance with regulations and rules therefore as required in the current manual of survey instructions of the United States Department of the Interior, Bureau of Land Management or by a decree of a Court of Law and/or that the corner points mentioned in lines 3, 4 and 5 above were in conformance with the rules of the Michigan Board of Land Surveyors or by a Decree of a Court of Law; established, re-established, monumented, re-monumented, recovered, found as expressed below:

NOTE: Not more than 4 corners, all in the same town and range, may be recorded on this certificate.

A. Description of original monument and accessories and/or subsequent restoration:

- G-8: 1/4 Corner common to Sections 21 & 22
- 1852 AUSTIN BURT, POST, W. ASH 8", S66°W, 19 LKS., MAPLE 22" N80 1/2°E, 23 LKS.
- 1894 GIBBS, TWO STONES WITH POST UNDER OLD CORNER SET IN SEC. 21
- 10-27-74 DAVID WHITTIER, SET 3/4" PIPE IN POST & 2 STONES SET BY GIBBS 1903, L.C.R.C. #372
- 4-08-85 JONES, 3/4" PIPE (132) 3-744

WITNESS NOTE: Witnesses from above surveys and LCRC'S are available in dossier file; which was presented to peer review committee and is on file at the Register of Deeds Office.


B. Description of corner evidence found and/or method applied in restoring or reestablishing corner:

- G-8: 1/4 Corner common to Sections 21 & 22
- FOUND 3/4" PIPE IN CENTER OF ROAD PER SURVEYS BY GIBBS, WHITTIER AND JONES.
- FOUND 2 1/2" X 24" OLD RUSTED PIPE, S 85° 53' 05" W, 5.97 FEET FROM THE 3/4" PIPE.
- VERIFIED 3/4" PIPE BY SURVEYING N 00° 40' 30" E, 661.08 FEET FROM S.W. CORNER OF SURVEY BY JONES. AFTER PEER REVIEW, ACCEPTED 3/4" PIPE AS PROPER POSITION OF CORNER.

Corner, G-8 was approved for remonumentation at a Peer Review Committee Meeting on 6-6, 1995.

C. Description of monument for corner and accessories established to perpetuate locating the position of the corner:

- G-8: 1/4 Corner common to Sections 21 & 22
- Set 5/8" x 18" re-rod with brass cap stamped "Midland Co. Remon. Cor. PS 9433" in Monument Box.
- Accepted as best available evidence of the position of the corner.
- N27°W, 394.82' - NAIL & TAG IN P.P.
- S62°W, 208.59' - NAIL & TAG IN P.P.
- N80°W, 25.14' - WEST END OF CULVERT.
- N80°E, 22.33' - EAST END OF CULVERT.

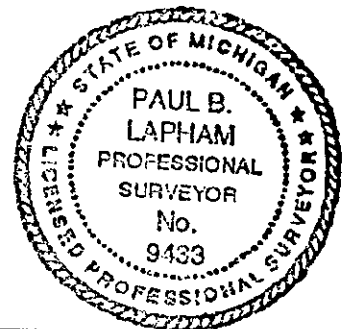

Signed by Paul B. Lapham
Surveyor's Michigan License No. 9433

Date 7-17-95