

LAND CORNER RECORDATION CERTIFICATE  
Filing Requirement of Act 74, Mich. P.A. 1970

11/12/96 919

For corners in

_____ MIDLAND _____ (County)	Located In:	Corner Code #
1. Public Land Survey	T <u>13N</u> R <u>2W</u>	<u>H-7</u>
	T _____ R _____	_____
	T _____ R _____	_____
	T _____ R _____	_____
2. Property Controlling in Section	S _____ T _____ R _____	_____
	S _____ T _____ R _____	_____
3. Miscellaneous Property in Sec.	S _____ T _____ R _____	_____
	S _____ T _____ R _____	_____

STATE OF MICHIGAN  
MIDLAND COUNTY  
REMONUMENTATION & FILED

20 DEC 96 2:07 P.M.

BEVERLY J THAYER  
REGISTER OF DEEDS

Register of Deeds Stamp & File Number

4. Lot No. \_\_\_\_\_, Recorded Plat \_\_\_\_\_  
5. Private Claims \_\_\_\_\_

I, MARK R. ROBISON, in a field survey on AUGUST, 1996 do hereby state that under requirements of P.A. 74, Michigan P.A. of 1970, the corner points mentioned in lines 1 and 2 above were in conformance with regulations and rules therefore as required in the current manual of survey instructions of the United States Department of the Interior, Bureau of Land Management or by a decree of a Court of Law and /or that the corner points mentioned in lines 3, 4 and 5 above were in conformance with the rules of the Michigan Board of Land Surveyors or by a Decree of a Court of Law, established, re-established, monumented, recovered, found as expressed below:

NOTE: Not more than 2 corners, all in the same town and range, may be recorded on this certificate.

	A	B	C	D	E	F	G	H	I	J	K	L	M
1													
2	6		5		4		3		2		1		
3													
4	7		8		9		10		11		12		
5													
6	18		17		16		15		14		13		
7													
8	19		20		21		22		23		24		
9													
10	30		29		28		27		26		25		
11													
12	31		32		33		34		35		36		
13													

A. Description of original monument and accessories and/or subsequent restoration:

1852 BURT, G.L.O.  
WT.-SET 1/4 SEC. POST  
MAPLE 8", S71 1/2"W 9 LKS.  
HEMLOCK 16" N62E. 21 LKS.  
  
3-28-02 GIBBS  
WT.-OLD 1/4 POST STANDING.  
40.13 TO G-7, 40.06 TO I-7.

11-09-92 GRAY  
WT.-FOUND 1/2" ROD IN MON. BOX.  
14° AZ 36.82' - NAIL & TAG IN TELE. POLE.  
110° AZ 79.15' - SHELL PIPELINE MARKER (FACE).  
199° AZ 29.72' - GREAT LAKES GAS PIPELINE MARKER (FACE).  
315° AZ 34.69' - GREAT LAKES GAS PIPELINE MARKER (FACE).

B. Description of corner evidence found and/or method applied in restoring or reestablishing corner:


FOUND MON. BOX WITH 1/2"x9" IRON ROD AND CAPPED IRON (1/2"x12"). FOUND AND CHECKED 1992 WITNESSES TO PIPE LINE MARKERS. FENCE LINES TO NORTH AND SOUTH. MEASURED EAST 2648.04' TO I-7 (GIBBS 2643.96'). MEASURED WEST 2647.98' TO G-7 (GIBBS 2648.58'). SEARCHED EAST OF MON. BOX WITH METAL DETECTOR FOR OTHER EVIDENCE. MEASURED EAST 1310' TO FENCE AND 1317' TO WEST. ACCEPTED CAPPED IRON IN MON. BOX. AS POSITION OF CORNER.

Corner, F-7 was approved for remonumentation at a Peer Review Committee Meeting on 11-12 19 96

C. Description of monument for corner and accessories established to perpetuate locating the position of the corner:

SET 3/4"x18" GAS PIPE WITH BRASS CAP STAMPED "MIDLAND CO. REMON. COR. P.S. 9433" IN MON. BOX. ACCEPTED AS BEST AVAILABLE EVIDENCE OF THE ACCEPTED POSITION OF THE CORNER.

WITNESSES:  
SOUTH, 29.50' - NAIL & TAG IN COR. FENCE POST.  
N05°E, 37.31' - NAIL & TAG IN NEW TELE. POLE.  
S57°W, 89.90' - NAIL & TAG IN TWIN 6" ASH.  
N65°E, 104.18' - NAIL & TAG IN 6" SPRUCE.  
MON. BOX IS 3.5' SOUTH OF CENTERLINE.

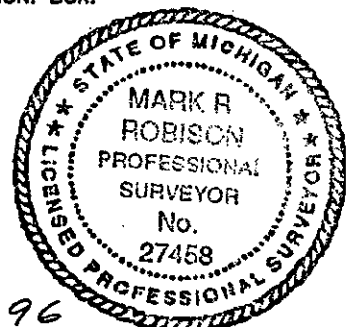

Signed by MARK R. ROBISON  
Surveyor's Michigan License No. 27458

Date 12-19-96