

**SURVEY &  
REMONUMENTATION**

APR 28 1995

**COMMISSION**

**APPROVED LAND CORNER  
P.A. 345 OF 1990  
MIDLAND COUNTY**

**127**

**LAND CORNER RECORDATION CERTIFICATE  
Filing Requirement of Act 74, Mich. P.A. 1970**

STATE OF MICHIGAN  
MIDLAND COUNTY  
REMONUMENTATION & FILED

For corners in 11/02/94 JLG

8 NOV 94 9:22 A.M.

BEVERLY J THAYER  
REGISTER OF DEEDS

**Register of Deeds Stamp & File Number**

<u>MIDLAND</u> (County)	Located In:	Corner Code #
1. Public Land Survey	T <u>13N</u> R <u>2W</u>	<u>J-7</u>
	T _____ R _____	_____
	T _____ R _____	_____
	T _____ R _____	_____
2. Property Controlling in Section	S _____ T _____ R _____	_____
	S _____ T _____ R _____	_____
3. Miscellaneous Property in Sec.	S _____ T _____ R _____	_____
	S _____ T _____ R _____	_____
4. Lot No. _____, Recorded Plat _____		
5. Private Claims _____		

A	B	C	D	E	F	G	H	I	J	K	L
2	6	5	4	3	2						
3											
4	7	8	9	10	11						
5											
6	18	17	16	15	14						
7											
8	19	20	21	22	23						
9											
10	30	29	28	27	26						
11											
12	31	32	33	34	35						
13											

I, PAUL B. LAPHAM, in a field survey on JULY, 19 94, do hereby certify that under requirements of P.A. 74, Michigan P.A. of 1970, the corner points mentioned in lines 1 and 2 above were in conformance with regulations and rules therefore as required in the current manual of survey instructions of the United States Department of the Interior, Bureau of Land Management or by a decree of a Court of Law and/or that the corner points mentioned in lines 3, 4 and 5 above were in conformance with the rules of the Michigan Board of Land Surveyors or by a Decree of a Court of Law; established, re-established, monumented, re-monumented, recovered, found as expressed below:


**NOTE: Not more than 4 corners, all in the same town and range, may be recorded on this certificate.**

A. Description of original monument and accessories and/or subsequent restoration:  
 J-7: 1/4 Corner common to Sections 14 & 23.  
 1852 - Austin Burt, Set Post, Maple 12" S 66-1/2°W, 35 lks Clump Oak, 8" N 32-1/2°E, 15 lks Page 307.  
 03/06/03 - Gibbs, Set Post, Oak Stump, N 32-1/2°E, 24 lks C.S.R. 1-36  
 10/6/89 - Jones, Plat of Survey & Notes, unrecorded

B. Description of corner evidence found and/or method applied in restoring or reestablishing corner:  
 J-7: 1/4 Corner common to Sections 14 & 23.  
 Found 1/2"x18" re-rod, 2615.98 feet East of N.W. Section Corner and on line with 1/8 Corner according to Jones notes.

Accepted as best available evidence of the position of the original corner & replaced with Standard Monument.  
 Corner, J-7 was approved for remonumentation at a Peer Review Committee Meeting on 11-02, 1994.

C. Description of monument for corner and accessories established to perpetuate locating the position of the corner:  
 J-7: 1/4 Corner common to Sections 14 & 23.  
 Set 5/8" x 18" re-rod with brass cap stamped "Midland Co. Remon. Cor. PS 9433" in Monument  
 North, 32.30' - Nail & Tag in Fence Post  
 N 20°E, 101.92' - Nail & Tag in 36" Oak  
 South, 53.61' - Nail & Tag in Power Pole  
 S 15°E, 44.57' - Nail & Tag in 6" Oak

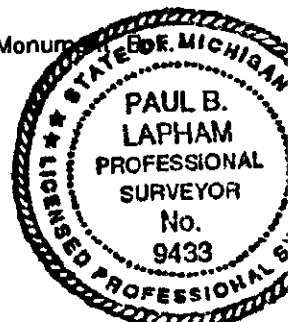

Signed by Paul B. Lapham Date 11-03-94  
 Surveyor's Michigan License No. 9433