

SURVEY & REMONUMENTATION

**APPROVED LAND CORNER
P.A. 345 OF 1990
MIDLAND COUNTY**

APR 28 1995

COMMISSION

**LAND CORNER RECORDATION CERTIFICATE
Filing Requirement of Act 74, Mich. P.A. 1970**

128

For corners in 11/03/94 989

MIDLAND <small>(County)</small>	Located In:	Corner Code ##	
1. Public Land Survey	T <u>13N</u> R <u>2W</u>	K-7	
	T _____ R _____	_____	
	T _____ R _____	_____	
	T _____ R _____	_____	
2. Property Controlling in Section	S _____ T _____ R _____	_____	
	S _____ T _____ R _____	_____	
3. Miscellaneous Property in Sec.	S _____ T _____ R _____	_____	
	S _____ T _____ R _____	_____	
4. Lot No. _____, Recorded Plat _____			
5. Private Claims _____			

STATE OF MICHIGAN
MIDLAND COUNTY
REMONUMENTATION & FILED

8 NOV 94 9:22 A.M.

BEVERLY J THAYER
REGISTER OF DEEDS

Register of Deeds Stamp & File Number

I, PAUL B. LAPHAM, in a field survey on JULY, 19 94, do hereby certify that under requirements of P.A. 74, Michigan P.A. of 1970, the corner points mentioned in lines 1 and 2 above were in conformance with regulations and rules therefore as required in the current manual of survey instructions of the United States Department of the Interior, Bureau of Land Management or by a decree of a Court of Law and/or that the corner points mentioned in lines 3, 4 and 5 above were in conformance with the rules of the Michigan Board of Land Surveyors or by a Decree of a Court of Law; established, re-established, monumented, re-monumented, recovered, found as expressed below:

	A	B	C	D	E	F	G	H	I	J	K
2	6	5	4	3	2						
3											
4	7	8	9	10	11						
5											
6	18	17	16	15	14						
7											
8	19	20	21	22	23						
9											
10	30	29	28	27	26						
11											
12	31	32	33	34	35						
13											


NOTE: Not more than 4 corners, all in the same town and range, may be recorded on this certificate.

A. Description of original monument and accessories and/or subsequent restoration:
 K-7: Section Corner common to Sections 13, 14, 23 & 24
 1852 - Austin Burt, Found old corner - did not witness
 03/06/03 - Gibbs, Steel Lever Pick, Pine Stump, S 43°W, 76 lks C.S.R. 1-36
 12/12/75 - David Whittier, Found 1/2" pipe in Mon. Box L.C.R.C. 378
 (1) NW to Nail & Tag in Guy Pole, 48.65' (Meas. N 34°W)
 (2) SE to Nail & Flag NE side Power Pole 60.2' (Meas. S 24°E)
 (3) SW to Nail & Tag NW side Power Pole 63.96' (Meas. S 43°W)

B. Description of corner evidence found and/or method applied in restoring or reestablishing corner:
 K-7: Section Corner common to Sections 13, 14, 23 & 24
 Found 1/2" x 12" pipe in Monument Box. Excavated to 3 feet and found no further evidence.
 Found Recorded Witnesses 1, 2 & 3.

Accepted as best available evidence of the position of the original corner & replaced with Standard Monument.
 Corner, K-7 was approved for remonumentation at a Peer Review Committee Meeting on 11-02, 1994.

C. Description of monument for corner and accessories established to perpetuate locating the position of the corner:
 K-7: Section Corner common to Sections 13, 14, 23 & 24
 Set 1/2" x 18" re-rod with brass cap stamped "Midland Co. Remon. Cor. PS 9433" in Monument Box.
 N 80°E, 132.95' - Nail & Tag in Guy Pole
 N 34°W, 48.65' - Nail & Tag in Guy Pole (1)
 S 24°E, 60.2' - Nail & Flag, NE side, Power Pole (2)
 S 43°W, 63.96' - Nail & Tag, NW side, Power Pole (3)

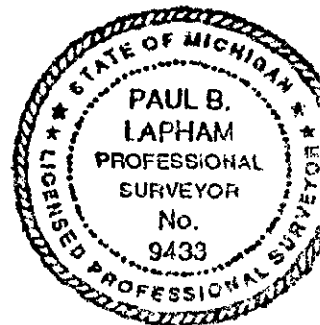

Signed by Paul B. Lapham Date 11-03-94
 Surveyor's Michigan License No. 9433