LAND CORNER RECORDATION CERTIFICATE

Filing Requirement of Act 74, Mich. P.A. 1970

For corners in
MIDLAND
(County)

	Located In:	Corner Code ##
1. Public Land Survey	T 14N R 2W	K-7, K-8
	T ___ R ___	
	T ___ R ___	
	T ___ R ___	
2. Property Controlling	S 22 T ___ R ___	14
in Section	S ___ T ___ R ___	
3. Miscellaneous	S ___ T ___ R ___	
Property in Sec.	S ___ T ___ R ___	

Register of Deeds Stamp & File Number

4. Lot No. _____ , Recorded Plat _____
5. Private Claims _____

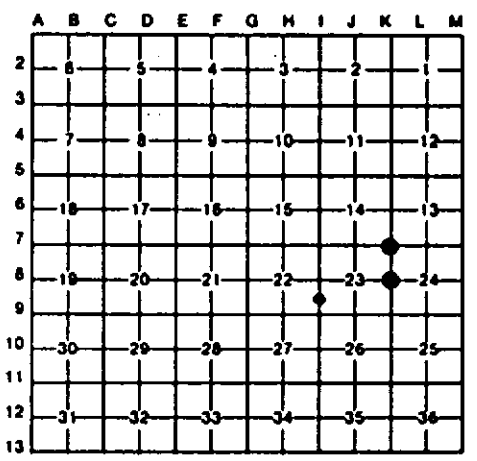

I, CARL F. ROSER, in a field survey on AUGUST 18, 19 92, do hereby certify that under requirements of P.A. 74, Michigan P.A. of 1970, the corner points mentioned in lines 1 and 2 above were in conformance with regulations and rules therefore as required in the current manual of survey instructions of the United States Department of the Interior, Bureau of Land Management or by a decree of a Court of Law and/or that the corner points mentioned in lines 3, 4 and 5 above were in conformance with the rules of the Michigan Board of Land Surveyors or by a Decree of a Court of Law; established, re-established, monumented, re-monumented, recovered, found as expressed below:

NOTE: Not more than 4 corners, all in the same town and range, may be recorded on this certificate.

A. Description of original monument and accessories and/or subsequent restoration:

K-7

K-8

14

B. Description of corner evidence found and/or method applied in restoring or reestablishing corner:

K-7
FD 1/2" REROD FOR NE COR SEC 23. CTR OF N-S BIT RD IS 1' E AND CTR OF E-W GRAVEL ROAD IS 8'± NORTH.

K-8
FD 3/4" PIPE FOR E 1/4 COR SEC 23. COR FITS RUDDELL ENG. CERT. OF SURVEYS IN INTERIOR OF SEC 23. CTR OF N-S BIT RD IS 3.5' EAST. CTR OF GRAVEL RD WEST IS 39' ±2'SOUTH.

14
ESTABLISHED SE COR OF NE 1/4 OF SE 1/4 OF SEC 22 PER STANDARD BLM INSTRUCTIONS.

C. Description of monument for corner and accessories established to perpetuate locating the position of the corner:

K-7
FD 1/2" REROD.

3" OAK	N35°W	61.82'
4" R PINE	N35°E	65.37'
3" MAP (CLP 13")	S70°E	86.73'
CTR S END 12" CMP		
	S65°W	44.2'

K-8
FD 3/4" PIPE W/RLS CAP.

9" OAK	N70°W	47.57'
*POWER POLE	S30°E	115.25'
CTR S END 18" CMP		
	S25°W	68.5'
CTR N END 18" CMP		
	S60°W	27.8'

*RLS W. RUDDELL WIT.

14
DROVE 5/8" X 34" REROD W/RLS CAP. SET CED POST W/LOC TAG.

2" OAK	N55°W	10.8'
5" MAPL (CLP 9)	N45°E	21.4'
2" OAK	S40°E	14.5'
6" TW MAPLE	S55°W	35.1'

STATE OF MICHIGAN
CARL F. ROSER
LAND SURVEYOR
No. 12028
REGISTERED LAND SURVEYOR

Signed by Carl F. Roser 12028 Date 3-12-93

Surveyor's Michigan License No. _____

FORM APPROVED BY MICHIGAN STATE BOARD OF LAND SURVEYORS, JAN. 28, 1971
REVISED MAY 14, 1975
REVISED JAN., 1983