

APPROVED LAND CORNER  
P.A. 345 OF 1990  
MIDLAND COUNTY

CLAYPOOL  
RECORDATION

REMON. COR. A-5, MIDLAND TWP.  
LAND CORNER RECORDATION CERTIFICATE  
Filing Requirement of Act 74, Mich. P.A. 1970

COMMISSION 198

9/25/95

For corners in  
Midland  
(County)

Located in: Corner Code #  
T 14N R 2E A-5  
T R  
T R  
T R  
S T R  
S T R  
S T R  
S T R

STATE OF MICHIGAN  
MIDLAND COUNTY  
FILED  
11 MAY 95 3:15 P.M.  
BEVERLY J THAYER  
REGISTER OF DEEDS

Register of Deeds Stamp & File Number

1. Public Land Survey
2. Property Controlling in Section
3. Miscellaneous Property in Sec.
4. Lot No. \_\_\_\_\_, Recorded Plat
5. Private Claims


	A	B	C	D	E	F	G	H	I	J	K	L	M
2	6	5	4	3	2	1							
3													
4	7	8	9	10	11	12							
5													
6	18	17	16	15	14	13							
7													
8	19	20	21	22	23	24							
9													
10	30	29	28	27	26	25							
11													
12	31	32	33	34	35	36							
13													

I, RODNEY CLAYPOOL, in a field survey on FEB 3, 1994, do hereby certify that under requirements of P.A. 74, Michigan P.A. of 1970, the corner points mentioned on lines 1 and 2 above were in conformance with regulations and rules therefore as required in the current manual of survey instructions of the United States Department of the Interior, Bureau of Land Management or by a decree of a Court of Law and/or that the corner points mentioned in lines 3, 4 and 5 above were in conformance with the rules of the Michigan Board of Land Surveyors or by a Decree of a Court of Law; re-established, monumented, re-monumented, recovered, found as expressed below:

**NOTE: Not more than 4 corners, all in the same town and range, may be recorded on this certificate.**

A. Description of original monument and accessories and/or subsequent restoration:

- A-5 Corner common to Section 7 and 18 on West town line
- |   |  |
|---|--|
| Government survey 1830's, set post          | Survey by J. Schafer, 1973, found iron   |
| Birch 17" N 21 Deg E 37L (24.42')           | Survey by J. Jones, 1984, 1987           |
| Hemlock 10", S 24 Deg E, 30L (19.80')       | found 3/4" pipe                          |
| Dow Survey, 1952 (E1-72370) axle shaft      | Survey by D. Ledy, 1990, found 3/4" pipe |
| Survey by M. Hunter, 1960, found axle shaft |  |

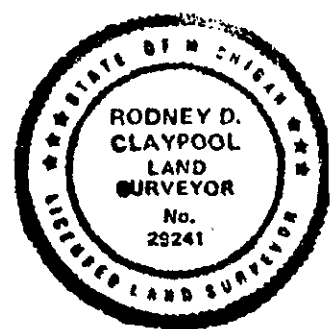

WITNESS NOTE: Witnesses from above surveys and LCRC's are available in dossier file; which was presented to peer review committee and is on file at the Register of Deeds Office.

B. Description of corner evidence found and/or method applied in restoring or reestablishing corner:

- A-5 Corner common to Section 7 and 18 on West town line  
Found 3/4" pipe (replaced with 5/8" rod and brass cap) per surveys by Dow, M. Hunter, J. Schafer, J. Jones, and D. Ledy.

Corner A-5 was approved for remonumentation at a Peer Review Committee Meeting on April 25, 1995.

C. Description of monument for corner and accessories established to perpetuate locating the position of the corner:

- A-5 Corner common to Section 7 and 18 on West town line  
Found 3/4" pipe (replaced with 5/8" rod and brass cap stamped Midland County Remon. Cor. PS 29241 in mon box) per surveys by Dow, M. Hunter, J. Schafer, J. Jones and D. Ledy; and is accepted as the best available evidence of the accepted position of the corner.
- |  |  |
|--|--|
| S 50 Deg E, 59.02', large spike in 30" Maple           | N 60 Deg W, 50.30', large spike in twin 10" Maple  |
| S 30 Deg E, 86.55', nail and plastic disc in 10" Maple | S 85 Deg E, 46.07', nail and plastic disc in 5" Ash                                      |
|  | North 92.38' and 0.78' West of controlling Homer Twp (T14N-R1E) line between M-5 and M-4 |

Signed by Rodney D. Claypool Date 05-11-95

Surveyor's Michigan License No. 29241