

APPROVED LAND CORNER
P.A. 345 OF 1990
MIDLAND COUNTY

4/25/95 J.P.J.

REMON. COR. A-6, MIDLAND TWP.
LAND CORNER RECORDATION CERTIFICATE
Filing Requirement of Act 74, Mich. P.A. 1970

199

For corners in
Midland

(County)

Located in: Corner Code #

- | | | |
|--|--|------------|
| 1. Public Land Survey | T <u>14N</u> R <u>2E</u> | <u>A-6</u> |
| | T <u> </u> R <u> </u> | <u> </u> |
| | T <u> </u> R <u> </u> | <u> </u> |
| | T <u> </u> R <u> </u> | <u> </u> |
| 2. Property Controlling
In Section | S <u> </u> T <u> </u> R <u> </u> | <u> </u> |
| | S <u> </u> T <u> </u> R <u> </u> | <u> </u> |
| 3. Miscellaneous
Property In Sec. | S <u> </u> T <u> </u> R <u> </u> | <u> </u> |
| | S <u> </u> T <u> </u> R <u> </u> | <u> </u> |
| 4. Lot No. <u> </u> , Recorded Plat <u> </u> | | |
| 5. Private Claims <u> </u> | | |

STATE OF MICHIGAN
MIDLAND COUNTY
FILED

11 MAY 95 3:15 P.M.

BEVERLY J THAYER
REGISTER OF DEEDS

Register of Deeds Stamp & File Number


I, RODNEY CLAYPOOL, in a field survey on FEBRUARY 2, 1994, do hereby certify that under requirements of P.A. 74, Michigan P.A. of 1970, the corner points mentioned on lines 1 and 2 above were in conformance with regulations and rules therefore as required in the current manual of survey instructions of the United States Department of the Interior, Bureau of Land Management or by a decree of a Court of Law and/or that the corner points mentioned in lines 3, 4 and 5 above were in conformance with the rules of the Michigan Board of Land Surveyors or by a Decree of a Court of Law; re-established, monumented, re-monumented, recovered, found as expressed below:

NOTE: Not more than 4 corners, all in the same town and range, may be recorded on this certificate.

	A	B	C	D	E	F	G	H	I	J	K	L	M
2	6	5	4	3	2	1							
3													
4	7	8	9	10	11	12							
5													
6	18	17	16	15	14	13							
7													
8	19	20	21	22	23	24							
9													
10	30	29	28	27	26	25							
11													
12	31	32	33	34	35	36							
13													

A. Description of original monument and accessories and/or subsequent restoration:

A-6 West 1/4 corner Section 18
Gibbs 1902
Set Cedar post 1.62 CH (106.92') N of 1/4 post
Sec 13 T14N-R1E
Survey by D. Whittier 1964, found corner
Survey by J. Jones, 1984, found 3/4" pipe
Survey by J. Jones, 1992, set PK nail
LCRC M. Bennett, 1975 (MDOT)

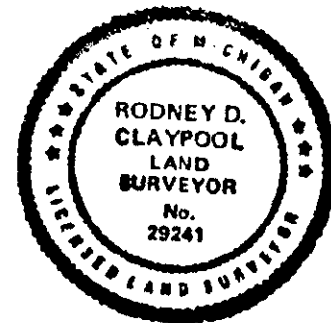

WITNESS NOTE: Witnesses from above surveys and LCRC's are available in dossier file; which was presented to peer review committee and is on file at the Register of Deeds Office.

B. Description of corner evidence found and/or method applied in restoring or reestablishing corner:

A-6 West 1/4 corner Section 18
Found PK nail (replaced with 5/8" rod and brass cap) per surveys by D. Whittier and J. Jones.

Corner A-6 was approved for remonumentation at a Peer Review Committee Meeting on April 25, 1995.

C. Description of monument for corner and accessories established to perpetuate locating the position of the corner:

A-6 West 1/4 corner Section 18
Found PK nail (replaced with 5/8" rod and brass cap stamped Midland County Remon. Cor. PS 29241 in mon box) per surveys by D. Whittier and J. Jones and is accepted as the best available evidence of the accepted position of the corner.
N 50 Deg E, 33.55', centerline hydrant
S 85 Deg E, 32.54', PK nail in 12" Pine
S 40 Deg W, 69.54', nail and plastic disc in 24" Pine
S 35 Deg E, 68.55', nail and plastic disc in 15" Pine

Signed by Rodney D. Claypool Date 05-11-95
Surveyor's Michigan License No. 29241