

JAN 21 1999

APPROVED LAND CORNER
P.A. 345 OF 1990
MIDLAND COUNTY

REMON. COR. A-9, MIDLAND TWP.
LAND CORNER RECORDATION CERTIFICATE
Filing Requirement of Act 74, Mich. P.A. 1970

SECTION

401

9/09/98 JJC

For corners in
Midland
(County)

Located in:	Corner Code #
T 14N R 2E	<u>A-9</u> ✓
T 14N R 1E	<u>M-9</u>
T ___ R ___	_____
T ___ R ___	_____
S ___ T ___ R ___	_____
S ___ T ___ R ___	_____
S ___ T ___ R ___	_____
S ___ T ___ R ___	_____

STATE OF MICHIGAN
MIDLAND COUNTY
REMONUMENTATION & FILED

12/16/1998 12:11:56 PM

BEVERLY J. THAYER
REGISTER OF DEEDS

Register of Deeds Stamp & File Number

1. Public Land Survey

2. Property Controlling in Section

3. Miscellaneous Property in Sec.

4. Lot No. _____, Recorded Plat _____

5. Private Claims _____

A B C D E F G H I J K L M

2	6	5	4	3	2	1
3						
4	7	8	9	10	11	12
5						
6	18	17	16	15	14	13
7						
8	19	20	21	22	23	24
9						
10	30	29	28	27	26	25
11						
12	31	32	33	34	35	36
13						



I, RODNEY CLAYPOOL, in a field survey on APRIL 16, 1997, do hereby certify that under requirements of P.A. 74, Michigan P.A. of 1970, the corner points mentioned on lines 1 and 2 above were in conformance with regulations and rules therefore as required in the current manual of survey instructions of the United States Department of the Interior, Bureau of Land Management or by a decree of a Court of Law and/or that the corner points mentioned in lines 3, 4 and 5 above were in conformance with the rules of the Michigan Board of Land Surveyors or by a Decree of a Court of Law; re-established, monumented, re-monumented, recovered, found as expressed below:

NOTE: Not more than 2 corners, all in the same town and range, may be recorded on this certificate.

A. Description of original monument and accessories and/or subsequent restoration:

A-9 Corner common to Sections 19, 30, T14N-R2E and Sections 24, 25, T14N-R1E

- Survey by Glo, 1830
- Survey by M. Hunter, 1954, Burgoons Subd
- Survey by D. Whittier, 1969, 1972
- Survey by J. Schafer, 1977, 1978, 1979, found 3/4" pipe
- Survey by M. MacDonald, 1984, found 3/4" pipe in mon box
- Survey by J. Jones, 1993, found 3/4" pipe

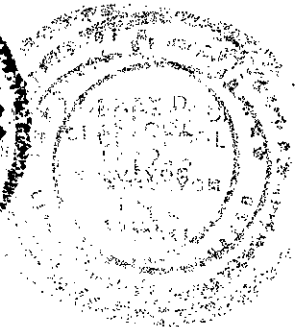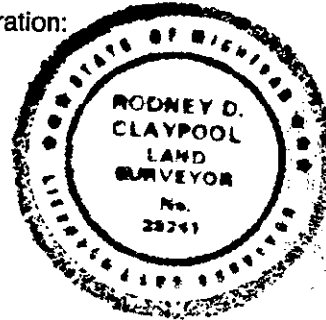

WITNESS NOTE: Witnesses from above surveys and LCRC's are available in dossier file; which was presented to peer review committee and is on file at the Register of Deeds Office.

B. Description of corner evidence found and/or method applied in restoring or reestablishing corner:

A-9 Corner common to Sections 19, 30, T14N-R2E and Sections 24, 25, T14N-R1E

Found 3/4" pipe in mon box per surveys by M. Hunter, D. Whittier, J. Schafer, M. MacDonald, and J. Jones

Corner A-9 was approved for remonumentation at a Peer Review Committee Meeting on September 9, 1998.

C. Description of monument for corner and accessories established to perpetuate locating the position of the corner:

A-9 Corner common to Sections 19, 30, T14N-R2E and Sections 24, 25, T14N-R1E

Found 3/4" pipe in mon box per surveys by M. Hunter, D. Whittier, J. Schafer, M. MacDonald, and J. Jones, replaced pipe with 3/4" pipe and brass cap stamped Midland Co. Remon Cor. PS 29241, and is accepted as the best available evidence of the position of the accepted corner.

- S 45 Deg W, 82.95', nail and plastic disc in power pole
- S 55 Deg W, 76.20', nail and plastic disc in power pole
- S 30 Deg E, 48.26', nail and plastic disc in power pole
- West, 17', centerline road to south
- S 50 Deg W, 129.70', NE corner (block) house

Signed by Rodney D. Claypool

Date 09-11-98

Surveyor's Michigan License No. 29241