

APPROVED LAND CORNER
P.A. 345 OF 1990
MIDLAND COUNTY

4/25/95 *[Signature]*

REMON. COR. A-10, MIDLAND TWP.
LAND CORNER RECORDATION CERTIFICATE
Filing Requirement of Act 74, Mich. P.A. 1970

RECORDED
MAY 11 1995
COMMISSIONER **201**

For corners in
Midland

(County)	Located in:	Corner Code #
1. Public Land Survey	T <u>14</u> N R <u>2</u> E	<u>A-10</u>
	T ___ R ___	_____
	T ___ R ___	_____
	T ___ R ___	_____
2. Property Controlling In Section	S ___ T ___ R ___	_____
	S ___ T ___ R ___	_____
3. Miscellaneous Property in Sec.	S ___ T ___ R ___	_____
	S ___ T ___ R ___	_____
4. Lot No. _____, Recorded Plat _____		
5. Private Claims _____		

STATE OF MICHIGAN
MIDLAND COUNTY
FILED

11 MAY 95 3:16 P.M.

BEVERLY J THAYER
REGISTER OF DEEDS

Register of Deeds Stamp & File Number

I, RODNEY CLAYPOOL, in a field survey on FEBRUARY 2, 1994, do hereby certify that under requirements of P.A. 74, Michigan P.A. of 1970, the corner points mentioned on lines 1 and 2 above were in conformance with regulations and rules therefore as required in the current manual of survey instructions of the United States Department of the Interior, Bureau of Land Management or by a decree of a Court of Law and/or that the corner points mentioned in lines 3, 4 and 5 above were in conformance with the rules of the Michigan Board of Land Surveyors or by a Decree of a Court of Law; re-established, monumented, re-monumented, recovered, found as expressed below:

NOTE: Not more than 4 corners, all in the same town and range, may be recorded on this certificate.

	A	B	C	D	E	F	G	H	I	J	K	L	M
2	6	5	4	3	2	1							
3													
4	7	8	9	10	11	12							
5													
6	18	17	16	15	14	13							
7													
8	19	20	21	22	23	24							
9													
10	30	29	28	27	26	25							
11													
12	31	32	33	34	35	36							
13													

A. Description of original monument and accessories and/or subsequent restoration:

A-10 Corner common to Section 30 T14N-R2E and Section 25 T14N-R1E

Government Survey 1830's, Page 160 and 168
Set post

B. Ash 10° S 16 Deg W, 28L (18.48')

B. Ash 9° N 42 Deg W, 14L (9.24')

Survey and LCRC by J. Schafer 1974, 1977
Found 1/2" pipe


Survey by J. Jones 1988
Found corner

Survey by D. Whittier 1966, Found Corner

Survey by D. Ledy 1988, 1989

Survey by M. Hunter 1967, Found Corner

Found corner

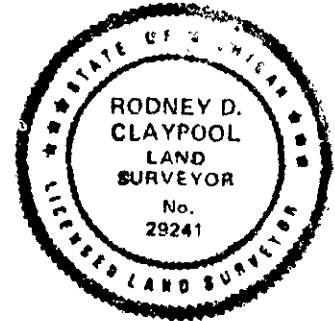

WITNESS NOTE: Witnesses from above surveys and LCRC's are available in dossier file; which was presented to peer review committee and is on file at the Register of Deeds Office.

B. Description of corner evidence found and/or method applied in restoring or reestablishing corner:

A-10 Corner common to Section 30 (T14N-R2E) and Section 25 (T14N-R1E)

Found 1/2" pipe; replaced with 5/8" rod and brass cap in monument box per surveys by D. Whittier, M. Hunter, J. Schafer, J. Jones and D. Ledy.

Corner A-10 was approved for remonumentation at a Peer Review Committee Meeting on April 25, 1995.

C. Description of monument for corner and accessories established to perpetuate locating the position of the corner:

A-10 Corner Common to Section 30 (T14N-R2E) and Section 25 (T14N-R1E)

Found 1/2" pipe replaced with 5/8" rod and brass cap (stamped Midland County Remon. Cor. PS 29241) in monument box; per surveys by D. Whittier, M. Hunter, J. Schafer, J. Jones and D. Ledy and is accepted as the best available evidence of the accepted position of the corner.

S 20 Deg E, 81.72', nail and plastic disc in 12" Apple
S 50 Deg W, 28.28', nail and disc in power pole

S 40 Deg W 64.58', nail and plastic disc in N. face power pole
N 70 Deg E 76.63', nail and plastic disc in 6" Elm

Signed by Rodney D. Claypool

Date 05-11-95

Surveyor's Michigan License No. 29241

Form approved by Michigan State Board of Land Surveyors, Jan. 28, 1971

Revised May 14, 1971

Revised Jan., 1983