

APPROVED LAND CORNER
P.A. 345 OF 1990
MIDLAND COUNTY

4/25/95 *[Signature]*

REMON. COR. A-11, MIDLAND TWP.
LAND CORNER RECORDATION CERTIFICATE
Filing Requirement of Act 74, Mich. P.A. 1970

202

For corners in
Midland

(County)

Located in: Corner Code #

- | | | |
|---------------------------------------|------------|------|
| 1. Public Land Survey | T 14N R 2E | A-11 |
| | T R | |
| | T R | |
| | T R | |
| 2. Property Controlling
In Section | S T R | |
| | S T R | |
| 3. Miscellaneous
Property in Sec. | S T R | |
| | S T R | |
4. Lot No. _____, Recorded Plat _____
5. Private Claims _____

STATE OF MICHIGAN
MIDLAND COUNTY
FILED

11 MAY 95 3:16 P.M.

BEVERLY J THAYER
REGISTER OF DEEDS

Register of Deeds Stamp & File Number

I, RODNEY CLAYPOOL, in a field survey on MARCH 3, 1994, do hereby certify that under requirements of P.A. 74, Michigan P.A. of 1970, the corner points mentioned on lines 1 and 2 above were in conformance with regulations and rules therefore as required in the current manual of survey instructions of the United States Department of the Interior, Bureau of Land Management or by a decree of a Court of Law and/or that the corner points mentioned in lines 3, 4 and 5 above were in conformance with the rules of the Michigan Board of Land Surveyors or by a Decree of a Court of Law; re-established, monumented, re-monumented, recovered, found as expressed below:

NOTE: Not more than 4 corners, all in the same town and range, may be recorded on this certificate.


A B C D E F G H I J K L M

2	6	5	4	3	2	1							
3													
4	7	8	9	10	11	12							
5													
6	18	17	16	15	14	13							
7													
8	19	20	21	22	23	24							
9													
10	30	29	28	27	26	25							
11													
12	31	32	33	34	35	36							
13													

A. Description of original monument and accessories and/or subsequent restoration:

- A-11 Corner common to Sections 30 and 31 T14N-R2E and Sections 25 and 36 T14N-R1E
 Government Survey 1830's Survey by J. Schafer 1974
 Set Post Set S 1/8 corner between Section 30, T14N-R2E and
 W. Ash 20" S 37 Deg W, 15 L. (9.9') Section 25 T14N-R1E by prorating actual distances
 Tamarack 9" N 28 Deg W, 20 L. (13.2') with Government Distance.
 Survey by D. Whittier 1968 Survey by D. Ledy 1987, 1988
 Found Indian Reserve line, 13.35 chains North Used S 1/8 corner between Section 30, T14N-R2E and
 (881.1') from section corner (Gov. Notes) Section 25, T14N-R1E
 Survey by J. Schafer 1973, 1988
 (Computed location of section corner)

WITNESS NOTE: Witnesses from above surveys and LCRC's are available in dossier file; which was presented to peer review committee and is on file at the Register of Deeds Office.

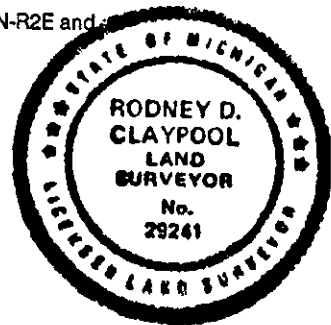

B. Description of corner evidence found and/or method applied in restoring or reestablishing corner:

- A-11 Corner common to Sections 30 and 31 T14N-R2E and Sections 25 and 36 T14N-R1E
 Set 3/4" pipe (3' long) with brass cap for corner; by using line from A-10 and S 1/8 corner (between Section 30 T14N-R2E and Section 25 T14N-R1E) extended and doubling distance. Per surveys by D. Whittier, J. Schafer and D. Ledy.

Corner A-11 was approved for remonumentation at a Peer Review Committee Meeting on April 25, 1995.

C. Description of monument for corner and accessories established to perpetuate locating the position of the corner:

- A-11 Corner common to Sections 30 and 31 T14N-R2E and Sections 25 and 36 T14N-R1E
 Set 3/4" pipe (3' long) with brass cap stamped Midland County Remon. Cor. PS 29241) per surveys by D. Whittier, J. Schafer and D. Ledy and is accepted as the best available evidence of the accepted position of the corner.
 N 25 Deg W, 14.39', nail and plastic disc in 10" Oak N 10 Deg E, 28.43', nail and plastic disc in 10" Oak
 S 60 Deg E, 7.94', nail and plastic disc in 5" Oak S 15 Deg W, 11.93', nail and plastic disc in 10" Ash
 On line with fence North and South 72' ± South of East West Fence

Signed by Rodney D. Claypool

Date 05-11-95

Surveyor's Michigan License No. 29241