

**SURVEY &  
REMONUMENTATION**

NOV 07 1994

COMMISSION

APPROVED LAND CORNER  
P.A. 345 OF 1990  
MIDLAND COUNTY

*JSD 2/24/94*

REMON. COR. E-2, CITY OF MIDLAND  
LAND CORNER RECORDATION CERTIFICATE  
Filing Requirement of Act 74, Mich. P.A. 1970

70

For corners in  
Midland

(County)

Located in: Corner Code #

- |                                       |   |     |   |    |     |
|---------------------------------------|---|-----|---|----|-----|
| 1. Public Land Survey                 | T | 14N | R | 2E | E-2 |
|                                       | T |     | R |    |     |
|                                       | T |     | R |    |     |
|                                       | T |     | R |    |     |
| 2. Property Controlling<br>in Section | S |     | T | R  |     |
|                                       | S |     | T | R  |     |
| 3. Miscellaneous<br>Property in Sec.  | S |     | T | R  |     |
|                                       | S |     | T | R  |     |
4. Lot No. \_\_\_\_\_, Recorded Plat \_\_\_\_\_  
5. Private Claims \_\_\_\_\_

STATE OF MICHIGAN  
MIDLAND COUNTY  
REMONUMENTATION & FILED

15 MAR 94 9:02 A.M.

BEVERLY J THAYER  
REGISTER OF DEEDS

Register of Deeds Stamp & File Number

I, RODNEY CLAYPOOL, in a field survey on DECEMBER, 1993, do hereby certify that under requirements of P.A. 74, Michigan P.A. of 1970, the corner points mentioned on lines 1 and 2 above were in conformance with regulations and rules therefore as required in the current manual of survey instructions of the United States Department of the Interior, Bureau of Land Management or by a decree of a Court of Law and/or that the corner points mentioned in lines 3, 4 and 5 above were in conformance with the rules of the Michigan Board of Land Surveyors or by a Decree of a Court of Law; re-established, monumented, re-monumented, recovered, found as expressed below:


**NOTE: Not more than 4 corners, all in the same town and range, may be recorded on this certificate.**

A B C D E F G H I J K L M

2	6	5	4	3	2	1
3						
4	7	8	9	10	11	12
5						
6	18	17	16	15	14	13
7						
8	19	20	21	22	23	24
9						
10	30	29	28	27	26	25
11						
12	31	32	33	34	35	36
13						

**A. Description of original monument and accessories and/or subsequent restoration:**

- |                                       |   |   |
|---------------------------------------|---|---|
| E-2 Corner common to Sections 4 and 5 | Wood post Government survey 1830's                                | Survey by D. Whittier 1976,<br>Brentwood Heights No. 3  |
|                                       | B. Ash 15', S 76 Deg E, 8 L (5.28')                               |   |
|                                       | Tamerack 5", N 73 Deg W, 18 L (11.88')                            | LCRC by D. Whittier 1976<br>found square head bolt in monument box<br>1' ± deep                             |
|                                       | M. Hunter, 1943, set Cor from previous witness                    | 2.7' East of centerline of Eastman Road<br>S 70 Deg W, nail and flag in North side of<br>power pole, 42.53' |
|                                       | Survey by A. Courtright 1951,<br>Cutler Subdivision, found corner | S 70 Deg E, nail and flag in North side of<br>telephone pole, 36.25'  |
|                                       | Survey by M. Hunter 1960, 1961, 1963, 1965,<br>found corner       |   |

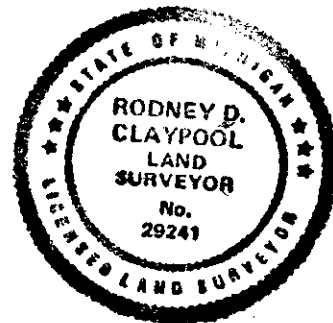

**B. Description of corner evidence found and/or method applied in restoring or reestablishing corner:**

- E-2 Corner common to Sections 4 and 5
- Found iron in mon box per surveys by A. Courtright, M. Hunter, D. Whittier and LCRC by D. Whittier

Corner E-2 was approved for remonumentation at a Peer Review Committee Meeting on FEB 24, 1994.

**C. Description of monument for corner and accessories established to perpetuate locating the position of the corner:**

- E-2 Corner common to Sections 4 and 5
- Found iron in mon box, set 3/4" pipe with brass cap (stamped Midland Co. Remon Cor. PS 29241) over top per surveys by A. Courtright, M. Hunter, D. Whittier and LCRC by D. Whittier and is accepted as the best available evidence of the perpetuation of the accepted corner.
- West, 40.08', concrete monument  
N 71 Deg W, 43.61', SE corner brick wall  
S 56 Deg E, 36.35', nail in power pole  
S 60 Deg W, 42.74', nail in power pole

Signed by Rodney D. Claypool Date 03-14-94

Surveyor's Michigan License No. 29241