

JAN 21 1999

APPROVED LAND CORNER
P.A. 345 OF 1990
MIDLAND COUNTY

REMON. COR. F-1, MIDLAND TWP.
LAND CORNER RECORDATION CERTIFICATE
Filing Requirement of Act 74, Mich. P.A. 1970

SECTION

400

For corners in
Midland
(County)

- 1. Public Land Survey
T 14N R 2E F-1
- T ___ R ___
- T ___ R ___
- T ___ R ___
- 2. Property Controlling in Section
S ___ T ___ R ___
- S ___ T ___ R ___
- 3. Miscellaneous Property in Sec.
S ___ T ___ R ___
- S ___ T ___ R ___
- 4. Lot No. _____, Recorded Plat _____
- 5. Private Claims _____

STATE OF MICHIGAN
MIDLAND COUNTY
REMONUMENTATION & FILED

12/16/1998 12:11:56 PM

BEVERLY J. THAYER
REGISTER OF DEEDS

Register of Deeds Stamp & File Number


I, RODNEY CLAYPOOL, in a field survey on JULY 21, 1997, do hereby certify that under requirements of P.A. 74, Michigan P.A. of 1970, the corner points mentioned on lines 1 and 2 above were in conformance with regulations and rules therefore as required in the current manual of survey instructions of the United States Department of the Interior, Bureau of Land Management or by a decree of a Court of Law and/or that the corner points mentioned in lines 3, 4 and 5 above were in conformance with the rules of the Michigan Board of Land Surveyors or by a Decree of a Court of Law; re-established, monumented, re-monumented, recovered, found as expressed below:

NOTE: Not more than 2 corners, all in the same town and range, may be recorded on this certificate.

	A	B	C	D	E	F	G	H	I	J	K	L	M
2	6	5	4	3	2	1							
3													
4	7	8	9	10	11	12							
5													
6	18	17	16	15	14	13							
7													
8	19	20	21	22	23	24							
9													
10	30	29	28	27	26	25							
11													
12	31	32	33	34	35	36							
13													

A. Description of original monument and accessories and/or subsequent restoration:

- F-1 N 1/4 corner Section 4, T14N-R2E
- Survey by Glo, 1830's, set post
- Survey by M. Hunter, 1944, 3/4" pipe
- Survey by W. Buhler, 1964, Sterling Park No. 2
- Survey by J. Jones, 1980, 1982, 1985, found pk
- LCRC by J. Jones, 1981, found pk, set 3/4" pipe
- LCRC by J. Erickson, 1982, found 3/4" pipe
- Plat of Indian Ridge, 1982

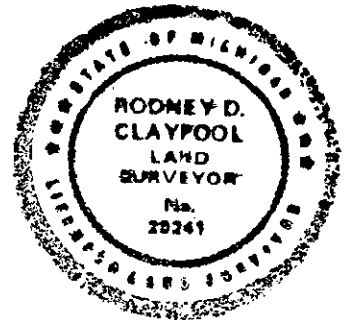

WITNESS NOTE: Witnesses from above surveys and LCRC's are available in dossier file; which was presented to peer review committee and is on file at the Register of Deeds Office.

B. Description of corner evidence found and/or method applied in restoring or reestablishing corner:

- F-1 N 1/4 corner Section 4, T14N-R2E
- Found pk nail per surveys by M. Hunter, W. Buhler, J. Jones, and LCRC by J. Jones and J. Erickson

Corner F-1 was approved for remonumentation at a Peer Review Committee Meeting on August 17, 1998.

C. Description of monument for corner and accessories established to perpetuate locating the position of the corner:

- F-1 N 1/4 corner Section 4, T14N-R2E
- Found pk nail per surveys by M. Hunter, W. Buhler, J. Jones and LCRC's by J. Jones and J. Erickson, replaced pk nail with 5/8" rod and brass cap stamped Midland Co. Remon Cor. PS 29241 in mon box, and is accepted as the best available evidence of the position of the accepted corner.
- South, 40.02', concrete plat mon
- N 60 Deg W, 70.12', nail in MDOT disc in power pole
- West, 60.42', pk nail S 1/4 corner Section 33, T15N-R2E
- East 61.25', centerline manhole
- S 2 Deg W, 41.45', pk nail in power pole
- N 45 Deg E, 57.62', nail and plastic disc in 15" Pine

Signed by Rodney D. Claypool

Date 09-11-98

Surveyor's Michigan License No. 29241