

NOV 07 1994

COMMISSION

APPROVED LAND CORNER  
P.A. 345 OF 1990  
MIDLAND COUNTY

*JCG 2/24/94*

78

REMON. COR. G-7, CITY OF MIDLAND  
LAND CORNER RECORDATION CERTIFICATE  
Filing Requirement of Act 74, Mich. P.A. 1970

STATE OF MICHIGAN  
MIDLAND COUNTY  
REMONUMENTATION & FILED

15 MAR 94 9:03 A.M.

BEVERLY J THAYER  
REGISTER OF DEEDS

For corners in  
Midland

(County)

Located in: Corner Code #

- |                                       |                           |            |
|---------------------------------------|---------------------------|------------|
| 1. Public Land Survey                 | T <u>14</u> N R <u>2E</u> | <u>G-7</u> |
|                                       | T ___ R ___               | _____      |
|                                       | T ___ R ___               | _____      |
|                                       | T ___ R ___               | _____      |
|                                       | T ___ R ___               | _____      |
| 2. Property Controlling<br>in Section | S ___ T ___ R ___         | _____      |
|                                       | S ___ T ___ R ___         | _____      |
| 3. Miscellaneous<br>Property in Sec.  | S ___ T ___ R ___         | _____      |
|                                       | S ___ T ___ R ___         | _____      |
| 4. Lot No. _____, Recorded Plat _____ |                           |            |
| 5. Private Claims _____               |                           |            |

Register of Deeds Stamp & File Number

I, RODNEY CLAYPOOL, in a field survey on NOVEMBER, 1993, do hereby certify that under requirements of P.A. 74, Michigan P.A. of 1970, the corner points mentioned on lines 1 and 2 above were in conformance with regulations and rules therefore as required in the current manual of survey instructions of the United States Department of the interior, Bureau of Land Management or by a decree of a Court of Law and/or that the corner points mentioned in lines 3, 4 and 5 above were in conformance with the rules of the Michigan Board of Land Surveyors or by a Decree of a Court of Law; re-established, monumented, re-monumented, recovered, found as expressed below:


**NOTE: Not more than 4 corners, all in the same town and range, may be recorded on this certificate.**

	A	B	C	D	E	F	G	H	I	J	K	L
2	6	5	4	3	2	1						
3												
4	7	8	9	10	11	12						
5												
6	18	17	16	15	14	13						
7												
8	19	20	21	22	23	24						
9												
10	30	29	28	27	26	25						
11												
12	31	32	33	34	35	36						
13												

A. Description of original monument and accessories and/or subsequent restoration:

G-7 Corner common to Section 15, 16, 21 and 22

- |   |  |
|---|--|
| Wood post Government survey 1830's  | Survey by F. Gibbs 1918<br>Plat of The Dow Chemical Company's Addition No. 1 |
| Hemlock 6", S 67 1/2 Deg W, 39 L, (25.74')                                  |  |
| Pine 10", N 74 Deg W, 47 L (31.02')   | Survey by M. Hunter 1956, 1959   |
| Survey by F. Gibbs 1917, The Dow Chemical Company's Addition, 3/4" gas pipe | Survey by J. Schafer 1979, found corner                                      |
| Survey by H. Snell 1918, Bradley Plat of Hillcrest                          |  |

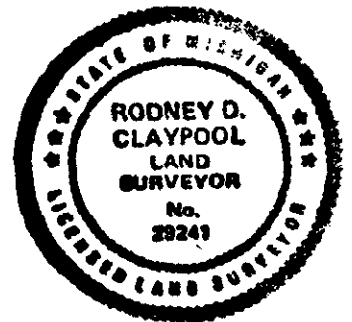

B. Description of corner evidence found and/or method applied in restoring or reestablishing corner:

G-7 Corner common to Section 15, 16, 21 and 22

Found square headed bolt spike in mon box per survey by F. Gibbs, H. Snell, M. Hunter, and J. Schafer

Corner G-7 was approved for remonumentation at a Peer Review Committee Meeting on FEB 24, 1994

C. Description of monument for corner and accessories established to perpetuate locating the position of the corner:

G-7 Corner common to Section 15, 16, 21 and 22

Found square headed bolt spike in mon box (set 3/4" pipe with brass cap stamped Midland Co. Remon Cor. PS 29241 on top) per surveys by F. Gibb, H. Snell, M. Hunter and J. Schafer; and is accepted as the best available evidence of the perpetuation of the accepted corner.

- S 45 Deg, W 47.73', nail and plastic disc in guy pole
- S 35 Deg, E 84.52', nail and plastic disc in 18" Boxelder
- N 45 Deg, E 47.58' nail and plastic disc in power pole
- N 45 Deg, W 46.84', nail and plastic disc in power pole

Signed by Rodney D. Claypool

Date 03-07-94  
R.C.

Surveyor's Michigan License No. 29241