

NOV 07 1994

COMMISSION

APPROVED LAND CORNER
P.A. 345 OF 1990
MIDLAND COUNTY

2/24/94 989

73

REMON. COR. I-8, CITY OF MIDLAND
LAND CORNER RECORDATION CERTIFICATE
Filing Requirement of Act 74, Mich. P.A. 1970

For corners in
Midland

(County)

Located in: Corner Code #

- 1. Public Land Survey T 14N R 2E I-8
- T R
- T R
- T R
- 2. Property Controlling S T R
- in Section S T R
- 3. Miscellaneous S T R
- Property in Sec. S T R
- 4. Lot No. _____, Recorded Plat _____
- 5. Private Claims _____

STATE OF MICHIGAN
MIDLAND COUNTY
REMONUMENTATION & FILED

15 MAR 94 9:03 A.M.

BEVERLY J THAYER
REGISTER OF DEEDS

Register of Deeds Stamp & File Number

I, RODNEY CLAYPOOL, in a field survey on DECEMBER, 1993, do hereby certify that under requirements of P.A. 74, Michigan P.A. of 1970, the corner points mentioned on lines 1 and 2 above were in conformance with regulations and rules therefore as required in the current manual of survey instructions of the United States Department of the interior, Bureau of Land Management or by a decree of a Court of Law and/or that the corner points mentioned in lines 3, 4 and 5 above were in conformance with the rules of the Michigan Board of Land Surveyors or by a Decree of a Court of Law; re-established, monumented, re-monumented, recovered, found as expressed below:

NOTE: Not more than 4 corners, all in the same town and range, may be recorded on this certificate.

	A	B	C	D	E	F	G	H	I	J	K	L	M
2	6	5	4	3	2	1							
3													
4	7	8	9	10	11	12							
5													
6	18	17	16	15	14	13							
7													
8	19	20	21	22	23	24							
9													
10	30	29	28	27	26	25							
11													
12	31	32	33	34	35	36							
13													

A. Description of original monument and accessories and/or subsequent restoration:

I-8 Corner common to Sections 22 and 23

Wood post Government survey 1830's

Survey by L. McGinnis 1984

Beech 12", S 57 Deg E, 20 L (13.20')

Survey by D. Ledy 1989, found iron in mon box
NW 79.7' to SE face power pole
SW 116.7' to NE face power pole
SE 70.9' to NW face power pole

Hemlock 28", N 69 Deg W, 29 L (19.14')

Survey by F. Gibbs 1906, set Cedar post stone at side for 1/4 corner and W BDY 23

Survey by D. Ledy 1990, found 1" bolt in box
NE 111.02' PK in power pole
SE 70.94' PK in power pole
SW 116.62' PK in power pole
NW 79.62' PK in guy pole


Survey by M. Hunter 1951, 1952, 1955, 1962 iron in pavement

Survey by D. Whittier 1971

Survey by J. Schafer 1976, found mon box

LCRC by A. Butterfield, 1979
found 1 1/4" iron bar in mon box
NW 79.7' to SE face power pole
SW 116.7' to NE face power pole
SE 70.90' to NW face power pole

Survey by J. Schafer 1978, found mon box
S 45 Deg E, tag in power pole, 67.0'
N 50 Deg W, tag in power pole, 79.7'
S 45 Deg W, SW cor crosswalk intersection, 69.10'

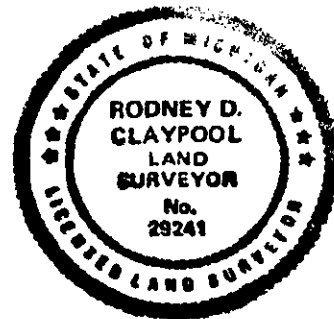

B. Description of corner evidence found and/or method applied in restoring or reestablishing corner:

I-8 Corner common to Sections 22 and 23

Found bolt (in concrete) in mon box per surveys by F. Gibbs, M. Hunter, D. Whittier, J. Schafer, L. McGinnis, D. Ledy, and LCRC by A. Butterfield

Corner I-8 was approved for remonumentation at a Peer Review Committee Meeting on FEB 24, 1994

C. Description of monument for corner and accessories established to perpetuate locating the position of the corner:

I-8 Corner common to Sections 22 and 23

Found bolt (in concrete) in mon box (due to concrete, I was unable to set brass cap) per surveys by F. Gibbs, M. Hunter, D. Whittier, J. Schafer, L. McGinnis, D. Ledy, and LCRC by A. Butterfield and is accepted as the best available evidence of the perpetuation of the accepted corner.

S 40 Deg E, 70.97', nail and plastic disc in power pole
S 50 Deg W, 116.67', nail and plastic disc in power pole

N 45 Deg W, 79.68, nail and plastic disc in power pole
N 40 Deg E, 111.08', nail and plastic disc in power pole

Signed by Rodney D. Claypool

Date 03-07-94

Surveyor's Michigan License No. 29241