

SURVEY &  
REMONUMENTATION

NOV 07 1994

COMMISSION

APPROVED LAND CORNER  
P.A. 345 OF 1990  
MIDLAND COUNTY

*929 2/24/94*

REMON. COR. K-11, CITY OF MIDLAND  
LAND CORNER RECORDATION CERTIFICATE  
Filing Requirement of Act 74, Mich. P.A. 1970

For corners in  
Midland

(County)

Located in: Corner Code #

- 1. Public Land Survey T 14N R 2E K-11  
T \_\_\_ R \_\_\_  
T \_\_\_ R \_\_\_  
T \_\_\_ R \_\_\_
- 2. Property Controlling S \_\_\_ T \_\_\_ R \_\_\_  
in Section S \_\_\_ T \_\_\_ R \_\_\_
- 3. Miscellaneous S \_\_\_ T \_\_\_ R \_\_\_  
Property in Sec. S \_\_\_ T \_\_\_ R \_\_\_
- 4. Lot No. \_\_\_\_\_, Recorded Plat \_\_\_\_\_
- 5. Private Claims \_\_\_\_\_

66

STATE OF MICHIGAN  
MIDLAND COUNTY  
REMONUMENTATION & FILED

15 MAR 94 9:01 A.M.

BEVERLY J THAYER  
REGISTER OF DEEDS

Register of Deeds Stamp & File Number


I, RODNEY CLAYPOOL, in a field survey on NOVEMBER 9, 1993, do hereby certify that under requirements of P.A. 74, Michigan P.A. of 1970, the corner points mentioned on lines 1 and 2 above were in conformance with regulations and rules therefore as required in the current manual of survey instructions of the United States Department of the interior, Bureau of Land Management or by a decree of a Court of Law and/or that the corner points mentioned in lines 3, 4 and 5 above were in conformance with the rules of the Michigan Board of Land Surveyors or by a Decree of a Court of Law; re-established, monumented, re-monumented, recovered, found as expressed below:

**NOTE: Not more than 4 corners, all in the same town and range, may be recorded on this certificate.**

	A	B	C	D	E	F	G	H	I	J	K	L	M
2	6	5	4	3	2	1							
3													
4	7	8	9	10	11	12							
5													
6	18	17	16	15	14	13							
7													
8	19	20	21	22	23	24							
9													
10	30	29	28	27	26	25							
11													
12	31	32	33	34	35	36							
13													

A. Description of original monument and accessories and/or subsequent restoration:

- K-11 Corner common Sec. 25, 26, 35 and 36  
Wood post Government survey 1830's  
Pine 30", S 52 Deg E, 7 L (4.62')  
Pine 26", N 31 Deg W, 29 L (19.14')  
Survey by Dow 1951, iron bar (bob sled runner)  
N 45 Deg E, 37.4' to corner fence post  
S 45 Deg W, 50.7' to corner fence post  
S 45 Deg E, 102.7' NW Cor HS  
N 45 Deg W, 34.0', to telephone pole  
(all measurements to near side)  
Survey by M. Hunter 1955, 1957, found corner  
Survey by D. Whittier 1972, found 3/4" rod  
N 45 Deg W, centerline hydrant , 56.03'  
S 50 Deg W, tag in telephone pole, 64.37'  
S 45 Deg E, tag in power pole, 66.30'
- Survey by J. Schafer 1973, found corner  
Survey by Edmands Engineering 1977, found PK  
N 60 Deg W, 84.25' to nail in power pole  
S 60 Deg W, 90.37' to nail in SE face power pole  
SE 66.28' to nail in NE face power pole  
Survey by Edmands Engineering 1983, found mon box  
NW 56' to top center hydrant  
NE 81.5' to face utility pole  
Survey by J. Jones 1984, found 2" pipe and bolt spike in mon box  
S 45 Deg E, nail and disc in power pole, 66.40'  
S 45 Deg W, 3/4" pipe, 46.78'  
S 50 Deg W, nail and washer in telephone pole, 64.37'  
N 45 Deg W, centerline fire hydrant, 56.0'  
Survey by M. MacDonald 1984, found mon box  
LCRC by D. Whittier 1972, found 3/8" rod  
S 55 Deg E, tag in telephone pole, 72.40'  
N 40 Deg E, square tag in power pole, 44.22'  
S 45 Deg W, centerline fire hydrant, 36.95'

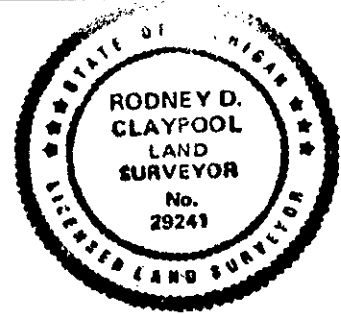

B. Description of corner evidence found and/or method applied in restoring or reestablishing corner:

- K-11 Corner Common to Sec. 25, 26, 35 and 36  
Found 2" pipe with bolt spike on top in mon box per surveys by Dow, M. Hunter, J. Schafer, Edmands Engineering, J. Jones, M. MacDonald, and LCRC by D. Whittier

Corner K-11 was approved for remonumentation at a Peer Review Committee Meeting on FEB. 24, 1994

C. Description of monument for corner and accessories established to perpetuate locating the position of the corner:

- K-11 Corner common to Sec. 25, 26, 35 and 36  
Found 2" pipe with bolt spike on top in mon box (removed bolt spike and set 5/8" rod with brass cap stamped Midland Co. Remon. Cor. PS 29241 in 2" pipe)  
surveys by Dow, M. Hunter, J. Schafer, Edmands Engineering, J. Jones, M. MacDonald and LCRC by D. Whittier and is accepted as the best available evidence of the position of the original corner  
S 45 Deg E, 66.39', nail and plastic disc in power pole  
S 45 Deg W, 90.48', nail and plastic disc in power pole  
N 50 Deg W, 56.08', centerline fire hydrant  
N 30 Deg W, 86.95', nail and plastic disc in power pole  
N 35 Deg E, 81.45', Nail and plastic disc in telephone stub  
S 50 Deg W, 64.48', nail in telephone pole

Signed by Rodney D. Claypool

Date 03-14-94

Surveyor's Michigan License No. 29241

Form approved by Michigan State Board of Land Surveyors, Jan. 28, 1971

Revised May 14, 1971

Revised Jan., 1983