

APPROVED LAND CORNER
P.A. 345 OF 1990
MIDLAND COUNTY

243

LAND CORNER RECORDATION CERTIFICATE
Filing Requirement of Act 74, Mich. P.A. 1970

STATE OF MICHIGAN
MIDLAND COUNTY
REMONUMENTATION & FILED

14 AUG 95 3:04 P.M.


BEVERLY J THAYER
REGISTER OF DEEDS

Register of Deeds Stamp & File Number

For corners in

MIDLAND (County)	Located In:	Corner Code #
1. Public Land Survey	T14N R1E	E-1
	T R	
	T R	
	T R	
2. Property Controlling in Section	S T R	
	S T R	
3. Miscellaneous Property in Sec.	S T R	
	S T R	

4. Lot No. _____, Recorded Plat _____
5. Private Claims _____

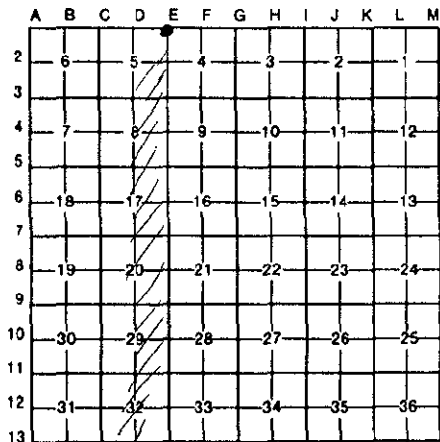

I, PAUL B. LAPHAM, in a field survey on MAY, 1995, do hereby certify that under requirements of P.A. 74, Michigan P.A. of 1970, the corner points mentioned in lines 1 and 2 above were in conformance with regulations and rules therefore as required in the current manual of survey instructions of the United States Department of the Interior, Bureau of Land Management or by a decree of a Court of Law and/or that the corner points mentioned in lines 3, 4 and 5 above were in conformance with the rules of the Michigan Board of Land Surveyors or by a Decree of a Court of Law; established, re-established, monumented, re-monumented, recovered, found as expressed below:

NOTE: Not more than 4 corners, all in the same town and range, may be recorded on this certificate.

A. Description of original monument and accessories and/or subsequent restoration:
E-1 N.W. CORNER SECTION 4, *CORNER COMMON TO E-13, T15N-R1E*
1831 HARVEY PARKE, INT. MERIDIAN 6.03 CHAINS N. OF CORNER SEC. 25 & 36 OF T15N, R1W
NO C.S.R.
1966 M.S.H.D. R/W MAP & WITNESS TO EST. COR.
8-75 SCHAFFER, FOUND 3/4" ROD, NO WITNESSES (132) 1-931
3-84 JONES, FOUND 1" ROD (132) 3-583
WITNESS NOTE: Witnesses from above surveys and LCRC's are available in dossier file; which was presented to peer review committee and is on file at the Register of Deeds Office.

B. Description of corner evidence found and/or method applied in restoring or reestablishing corner:
E-1 N.W. CORNER SECTION 4
Found 1" dia. solid iron bar per surveys by Schaffer & Jones. Could not remove left iron bar meas. 399.51 South to offset corner.

SURVEY &
REMONUMENTATION

AUG 1995

CORRECTION

Corner, E-1 was approved for remonumentation at a Peer Review Committee Meeting on 7-18, 1995.

C. Description of monument for corner and accessories established to perpetuate localizing the position of the corner:

E-1 N.W. CORNER SECTION 4
Found 1" dia. solid iron bar per surveys by Schaffer and Jones. Accepted as best available evidence of the accepted position of the corner.

- NORTH 94.44' - N&T IN POWER POLE
- N28°E 28.43' - N&T IN 14" PINE
- EAST 26.56' - N&T IN 17" OAK
- S21°E 13.67' - N&T IN 12" OAK
- N50°W 48.63' - N&T IN 15" PINE



Signed by Paul B. Lapham
Surveyor's Michigan License No. 9433

Date 7/21/95