

APPROVED LAND CORNER
P.A. 345 OF 1990
MIDLAND COUNTY

245

LAND CORNER RECORDATION CERTIFICATE
Filing Requirement of Act 74, Mich. P.A. 1970

STATE OF MICHIGAN
MIDLAND COUNTY
REMONUMENTATION & FILED

14 AUG 95 3:04 P.M.

BEVERLY J THAYER
REGISTER OF DEEDS

Register of Deeds Stamp & File Number

For corners in

MIDLAND (County)	Located In:	Corner Code #
1. Public Land Survey	T <u>14N</u> R <u>1E</u>	<u>E-3</u>
	T _____ R _____	_____
	T _____ R _____	_____
	T _____ R _____	_____
2. Property Controlling in Section	S _____ T _____ R _____	_____
	S _____ T _____ R _____	_____
3. Miscellaneous Property in Sec.	S _____ T _____ R _____	_____
	S _____ T _____ R _____	_____

4. Lot No. _____, Recorded Plat _____
5. Private Claims _____

I, PAUL B. LAPHAM, in a field survey on MAY, 19 95, do hereby certify that under requirements of P.A. 74, Michigan P.A. of 1970, the corner points mentioned in lines 1 and 2 above were in conformance with regulations and rules therefore as required in the current manual of survey instructions of the United States Department of the Interior, Bureau of Land Management or by a decree of a Court of Law and/or that the corner points mentioned in lines 3, 4 and 5 above were in conformance with the rules of the Michigan Board of Land Surveyors or by a Decree of a Court of Law; established, re-established, monumented, re-monumented, recovered, found as expressed below:

NOTE: Not more than 4 corners, all in the same town and range, may be recorded on this certificate.

A. Description of original monument and accessories and/or subsequent restoration:
E-3 WEST SECTION CORNER 4 & 9


- 1831 HARVEY PARKE, INT. MERIDIAN 7.84 N. OF SECTION CORNER, PINE 14" N23E 27, PINE 24" S32E 44.
- 1960 M.S.H.D. NO COR. MATERIAL NOTED.
- 1-13-76 HERBERT FLUHARTY, FOUND MON. BOX APPROX. 250' S OF BRIDGE ON MERIDIAN RD. L.C.R.C.
- 1-19-78 SCHAFER, FOUND 3/4" PIPE IN MON. BOX (132) 2-480

WITNESS NOTE: Witnesses from above surveys and LCRC's are available in dossier file; which was presented to peer review committee and is on file at the Register of Deeds Office.

B. Description of corner evidence found and/or method applied in restoring or reestablishing corner:

E-3 West Section Corner common to Sections 4 & 9

Found 3/4" x 24" rod in mon. box per surveys by M.S.H.D., Fluharty & Schafer. Meas. South 517.35' to M-1, T14N, R1W (GLO 517.44')

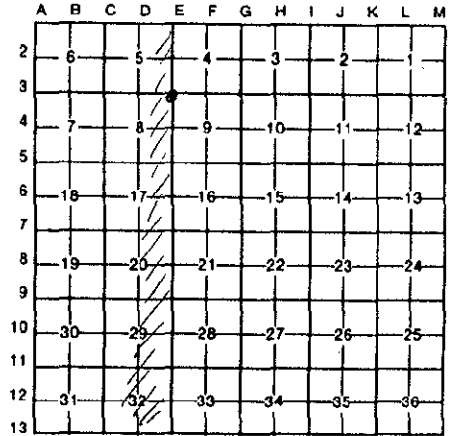

SURVEY &
FIELD DIVISION

7-18-95

COMMISSION

Corner, E-3 was approved for remonumentation at a Peer Review Committee Meeting on 7-18, 19 95.

C. Description of monument for corner and accessories established to perpetuate locating the position of the corner:

E-3 West Section Corner common to Sections 4 & 9
Set 5/8" x 18" re-rod with brass cap stamped "Midland Co. Remon. Cor. PS 9433" in Monument Box.
Accepted as best available evidence of accepted position of corner.

- S32°W 81.60' - N&T IN 20" OAK
- S70°E 63.10' - N&T IN N.E. TWIN 15" PINE
- N43°E 54.77' - N&T IN 22" PINE
- N45°W 55.30' - PHONE RISER



Signed by Paul B. Lapham

Date 7/21/95

Surveyor's Michigan License No. 9433