

APPROVED LAND CORNER  
P.A. 345 OF 1990  
MIDLAND COUNTY

6/6/95 *[Signature]*

LAND CORNER RECORDATION CERTIFICATE  
Filing Requirement of Act 74, Mich. P.A. 1970


For corners in

|                                       |                          |               |
|---------------------------------------|--------------------------|---------------|
| <u>MIDLAND</u><br>(County)            | Located In:              | Corner Code # |
| 1. Public Land Survey                 | T <u>14N</u> R <u>1E</u> | <u>E-4</u>    |
|                                       | T _____ R _____          | _____         |
|                                       | T _____ R _____          | _____         |
|                                       | T _____ R _____          | _____         |
| 2. Property Controlling<br>in Section | S _____ T _____ R _____  | _____         |
|                                       | S _____ T _____ R _____  | _____         |
| 3. Miscellaneous<br>Property in Sec.  | S _____ T _____ R _____  | _____         |
|                                       | S _____ T _____ R _____  | _____         |
| 4. Lot No. _____, Recorded Plat _____ |                          |               |
| 5. Private Claims _____               |                          |               |

2223  
STATE OF MICHIGAN  
MIDLAND COUNTY  
FILED  
19 JUL 95 10:53 A.M.  
BEVERLY J THAYER  
REGISTER OF DEEDS

Register of Deeds Stamp & File Number

I, PAUL B. LAPHAM, in a field survey on MAY, 19 95, do hereby certify that under requirements of P.A. 74, Michigan P.A. of 1970, the corner points mentioned in lines 1 and 2 above were in conformance with regulations and rules therefore as required in the current manual of survey instructions of the United States Department of the Interior, Bureau of Land Management or by a decree of a Court of Law and/or that the corner points mentioned in lines 3, 4 and 5 above were in conformance with the rules of the Michigan Board of Land Surveyors or by a Decree of a Court of Law; established, re-established, monumented, re-monumented, recovered, found as expressed below:

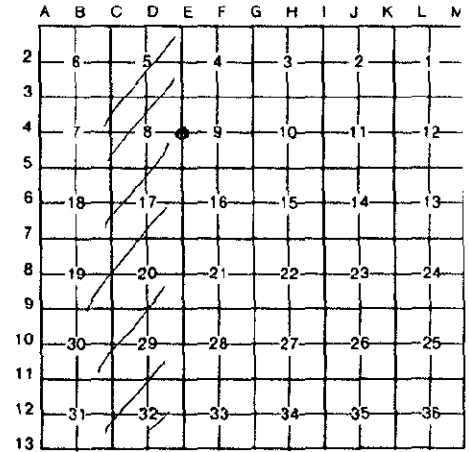

**NOTE: Not more than 4 corners, all in the same town and range, may be recorded on this certificate.**

A. Description of original monument and accessories and/or subsequent restoration:  
E-4: West 1/4 Corner Section 9

- 1831 HARVEY PARKE, NOT SET IN G.L.O. SURVEY
- 1960 M.S.H.D. 3/4" PIPE
- 1-13-76 FLUHARTY, FOUND MON. BOX AT Q MERIDIAN RD. L.C.R.C.
- 1-78 SCHAFFER, FOUND 3/4" ROD IN MON. BOX (132) 2-480
- 5-78 SCHAFFER, NO WITNESSES (132) 2-565

WITNESS NOTE: Witnesses from above surveys and LCRC's are available in dossier file; which was presented to peer review committee and is on file at the Register of Deeds Office.

B. Description of corner evidence found and/or method applied in restoring or reestablishing corner:

E-4: West 1/4 Corner Section 9

Found 3/4" x 24" rod per surveys by M.S.H.D. Fluharty & Schafer, meas. South 515.16' to M-2, T14N, R1W, Mean G.L.O. = 507.54

COURTYN  
REMONUMENTATION

1995


Corner, E-4 was approved for remonumentation at a Peer Review Committee Meeting on 6-6, 19 95.

C. Description of monument for corner and accessories established to perpetuate locating the position of the corner:

E-4: West 1/4 Corner Section 9

Set 5/8" x 36" re-rod with brass cap stamped "Midland Co. Remon. Cor. PS 9433" in Monument Box per surveys by M.S.H.D., Fluharty and Schafer. Accepted as best available evidence of the accepted position of the corner.

- N42°E 97.30' - N&T IN 20" PINE
- N75°W 48.20' - N&T IN 8" TWIN ASH
- S65°W 54.10' - N&T IN 10" OAK
- N80°E 59.00' - N&T IN 16" PINE

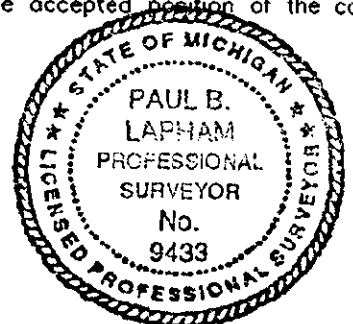

Signed by Paul B. Lapham Date 6-12-95  
Surveyor's Michigan License No. 9433