

APPROVED LAND CORNER
P.A. 345 OF 1990
MIDLAND COUNTY

6/6/95

LAND CORNER RECORDATION CERTIFICATE
Filing Requirement of Act 74, Mich. P.A. 1970

For corners in

224

| MIDLAND (County) | Located In: | Corner Code # |
|---------------------------------------|-------------------------|---------------|
| 1. Public Land Survey | T 14N R 1E | E-5 |
| | T _____ R _____ | _____ |
| | T _____ R _____ | _____ |
| | T _____ R _____ | _____ |
| 2. Property Controlling in Section | S _____ T _____ R _____ | _____ |
| | S _____ T _____ R _____ | _____ |
| 3. Miscellaneous Property in Sec. | S _____ T _____ R _____ | _____ |
| | S _____ T _____ R _____ | _____ |

STATE OF MICHIGAN
MIDLAND COUNTY
FILED


19 JUL 95 10:54 A.M.

BEVERLY J THAYER
REGISTER OF DEEDS

Register of Deeds Stamp & File Number

4. Lot No. _____, Recorded Plat _____
5. Private Claims _____

I, PAUL B. LAPHAM, in a field survey on MAY, 19 95, do hereby certify that under requirements of P.A. 74, Michigan P.A. of 1970, the corner points mentioned in lines 1 and 2 above were in conformance with regulations and rules therefore as required in the current manual of survey instructions of the United States Department of the Interior, Bureau of Land Management or by a decree of a Court of Law and/or that the corner points mentioned in lines 3, 4 and 5 above were in conformance with the rules of the Michigan Board of Land Surveyors or by a Decree of a Court of Law; established, re-established, monumented, re-monumented, recovered, found as expressed below:

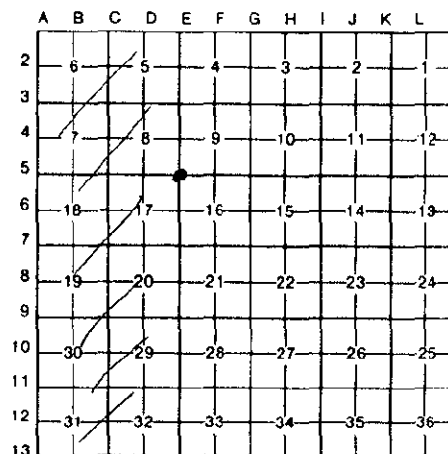

NOTE: Not more than 4 corners, all in the same town and range, may be recorded on this certificate.

A. Description of original monument and accessories and/or subsequent restoration:

- E-5 WEST SECTION CORNER 9 & 16
- 1831 HARVEY PARKE, INT. MERIDIAN 7.84 N. OF SEC. COR. MAPLE 8" SB3E 9, MAPLE 15" N16E 11.
- 1902 GIBBS, IRON PIN
- 1960 M.S.H.D. 1" PIPE 3" BELOW SURFACE
- 7-24-73 SCHAFER, FOUND 3/4" ROD IN MON. BOX (132) 1-391
- 10-22-73 SCHAFER, 3/4" ROD IN MON. BOX L.C.R.C. #243
- 1-10-76 FLUHARTY, FOUND 3/4" ROD IN MON. BOX @ OF 3 WAY INTERSECTION (L.C.R.C.)
- 10-25-78 SCHAFER, NO WITNESSES (132) 2-694
- 3-26-90 LEDY, FOUND 3/4" ROD IN MON. BOX (132) 4-600
- 6-25-92 JONES, FOUND 5/8" ROD IN MON. BOX (132) 4-904

WITNESS NOTE: Witnesses from above surveys and LCRC's are available in dossier file; which was presented to peer review committee and is on file at the Register of Deeds Office.

B. Description of corner evidence found and/or method applied in restoring or reestablishing corner:

E-5 WEST SECTION CORNER 9 & 16

Found 3/4" x 24" rod inside 1" x 26" pipe per surveys by M.S.H.D., Schafer, Fluharty, Ledy & Jones, meas. SOUTH 512.98 feet to M-3, T14N, R1W, (G.L.O. = 517.44')

SURVEY &
REMONUMENTATION

6-6-95

Corner, E-5 was approved for remonumentation at a Peer Review Committee Meeting on 6-6, 1995.

C. Description of monument for corner and accessories established to perpetuate locating the position of the corner:

E-5 West Section Corner 9 & 16

Set 5/8" x 18" re-rod with brass cap stamped "Midland Co. Remon. Cor. PS 9433" in Monument Box per surveys by M.S.H.D., Schafer, Fluharty, Jones and Ledy. Accepted as best available evidence of the accepted position of the corner.

- S50°E 67.10' - N&T IN TELE. POLE
- S40°E 63.12' - N&T IN POWER POLE
- N45°E 48.53' - N&T IN POWER POLE
- N45°W 46.20' - N&T IN GUY POLE



Signed by Paul B. Lapham

Date 6-12-95

Surveyor's Michigan License No. 9433