

APPROVED LAND CORNER
P.A. 345 OF 1990
MIDLAND COUNTY

LAND CORNER RECORDATION CERTIFICATE
Filing Requirement of Act 74, Mich. P.A. 1970

225

6/16/95 JBL

For corners in

MIDLAND (County)	Located In:	Corner Code #
1. Public Land Survey	T 14N R 1E	E-6
	T _____ R _____	_____
	T _____ R _____	_____
	T _____ R _____	_____
2. Property Controlling in Section	S _____ T _____ R _____	_____
	S _____ T _____ R _____	_____
3. Miscellaneous Property in Sec.	S _____ T _____ R _____	_____
	S _____ T _____ R _____	_____

STATE OF MICHIGAN
MIDLAND COUNTY
FILED


19 JUL 95 10:54 A.M.

BEVERLY J THAYER
REGISTER OF DEEDS

Register of Deeds Stamp & File Number

4. Lot No. _____, Recorded Plat _____
5. Private Claims _____

I, PAUL B. LAPHAM, in a field survey on MAY, 19 95, do hereby certify that under requirements of P.A. 74, Michigan P.A. of 1970, the corner points mentioned in lines 1 and 2 above were in conformance with regulations and rules therefore as required in the current manual of survey instructions of the United States Department of the Interior, Bureau of Land Management or by a decree of a Court of Law and/or that the corner points mentioned in lines 3, 4 and 5 above were in conformance with the rules of the Michigan Board of Land Surveyors or by a Decree of a Court of Law, established, re-established, monumented, re-monumented, recovered, found as expressed below:

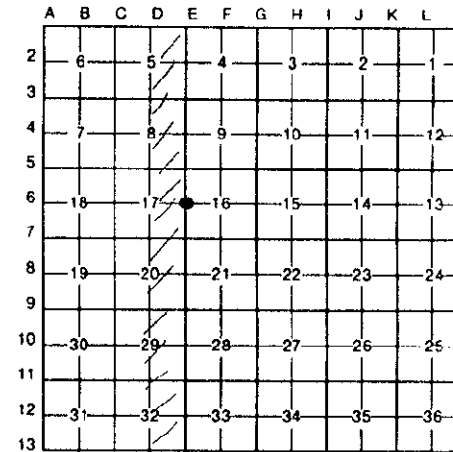

NOTE: Not more than 4 corners, all in the same town and range, may be recorded on this certificate.

A. Description of original monument and accessories and/or subsequent restoration:
E-6 WEST 1/4 CORNER SECTION 16

- 1831 HARVEY PARKE, NOT SET IN G.L.O. SURVEY
- 1902 GIBBS, SET W. OAK POST AT AVERAGE DIST ON TRUE LINE
- 1960 M.S.H.D. 3/4" PIPE
- 10-22-73 SCHAFFER, FOUND 3/4" ROD IN PAVED OVER MON. BOX L.C.R.C.
- 5-30-90 RUELLELL, FOUND ROD IN MON. BOX IN Q PAVEMENT (132) 4-624

WITNESS NOTE: Witnesses from above surveys and LCRC's are available in dossier file; which was presented to peer review committee and is on file at the Register of Deeds Office.

B. Description of corner evidence found and/or method applied in restoring or reestablishing corner:

E-6 WEST 1/4 CORNER SECTION 16

Found 3/4" x 24" Iron in Mon. Box per surveys by M.S.H.D., Schafer and Ruddell.
Meas. South 496.75 feet to M-4, T14N, R1W. G.L.O. mean 489.79'.

SURVEY &
REMONUMENTATION

1995

1995


Corner, E-6 was approved for remonumentation at a Peer Review Committee Meeting on 6-6, 19 95.

C. Description of monument for corner and accessories established to perpetuate locating the position of the corner:

E-6 WEST 1/4 CORNER SECTION 16

Set 5/8" x 36" re-rod with brass cap stamped "Midland Co. Remon. Cor. PS 9433" in Monument Box per surveys by M.S.H.D., Schafer and Ruddell. Accepted as best available evidence of the accepted position of the corner.

- S45°E 40.05' - N&T IN TELE. POLE
- N20°E 103.4' - N&T IN TELE. POLE
- N65°E 52.3' - N&T IN 8" OAK
- N60°W 66.4' - N&T IN FENCE POST

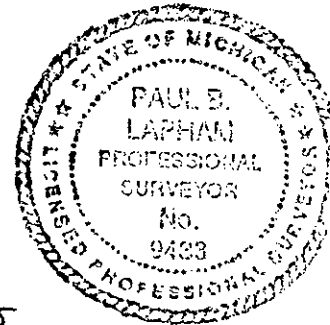

Signed by Paul B. Lapham

Date 6-12-95

Surveyor's Michigan License No. 9433