

APPROVED LAND CORNER  
P.A. 345 OF 1990  
MIDLAND COUNTY

LAND CORNER RECORDATION CERTIFICATE  
Filing Requirement of Act 74, Mich. P.A. 1970


For corners in

226

MIDLAND (County)		Located In:	Corner Code #
1. Public Land Survey		T 14N R 1E	E-9
		T _____ R _____	_____
		T _____ R _____	_____
		T _____ R _____	_____
2. Property Controlling in Section	S _____ T _____ R _____	_____	_____
	S _____ T _____ R _____	_____	_____
3. Miscellaneous Property in Sec.	S _____ T _____ R _____	_____	_____
	S _____ T _____ R _____	_____	_____
4. Lot No. _____, Recorded Plat _____			
5. Private Claims _____			

STATE OF MICHIGAN  
MIDLAND COUNTY  
FILED  
19 JUL 95 10:54 A.M.  
BEVERLY J THAYER  
REGISTER OF DEEDS  
Register of Deeds Stamp & File Number

I, PAUL B. LAPHAM, in a field survey on MAY, 19 95  
do hereby certify that under requirements of P.A. 74, Michigan P.A. of 1970, the corner points mentioned  
in lines 1 and 2 above were in conformance with regulations and rules therefore as required in the  
current manual of survey instructions of the United States Department of the Interior, Bureau of Land  
Management or by a decree of a Court of Law and/or that the corner points mentioned in lines 3, 4 and 5  
above were in conformance with the rules of the Michigan Board of Land Surveyors or by a Decree of a  
Court of Law; established, re-established, monumented, re-monumented, recovered, found as  
expressed below:

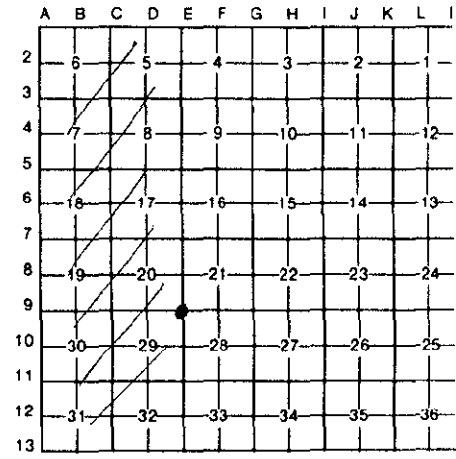

**NOTE: Not more than 4 corners, all in the same town and range, may be recorded on this certificate.**

A. Description of original monument and accessories and/or subsequent restoration:  
E-9 CORNER COMMON TO SECTIONS 20, 21, 28 AND 29  
1831, HARLEY PARKE, INT. MERIDIAN 7.26 N. OF SEC. COR. HEMLOCK 14, 563 2/3 E, 1.23, HEMLOCK 9, N31E 63.  
C.S.R. 1913 GIBBS, OLD COR. POST STANDING, SET 1/2" x 3' CORRUGATED ROD & OLD PLOW COULTER AT  
7.26 CH. N. OF COR. FOR SEC. 13 & 14  
M.S.H.D. 1/2" IRON ROD 6" DEEP  
7-19-90 LEDY, DID NOT NOTE COR. MATERIAL (132) 4-708  
7-19-90 LEDY, DID NOT NOTE COR. MATERIAL (132) 4-779  
WITNESS NOTE: Witnesses from above surveys and LCRC's are available in dossier file; which was  
presented to peer review committee and is on file at the Register of Deeds Office.

B. Description of corner evidence found and/or method applied in restoring or reestablishing corner:  
E-9 CORNER COMMON TO SECTIONS 20, 21, 28 AND 29  
Found 3/4" x 24" rod in mon. box per surveys by Gibbs, M.S.H.D., and Ledy. Meas. SOUTH 478.10'  
to corner Section 13-24, T14N, R1W per Gibbs and G.L.O. Ledy, measures 455.24 feet to iron  
in centerline Chippewa River Road.

PAUL B. LAPHAM  
MIDLAND COUNTY  
REGISTER OF DEEDS

Corner, E-9 was approved for remonumentation at a Peer Review Committee Meeting on 6-6, 1995.  
C. Description of monument for corner and accessories established to perpetuate locating the position of the corner:  
E-9 CORNER COMMON TO SECTIONS 20, 21, 28 AND 29  
Set 5/8" x 18" re-rod with brass cap stamped "Midland Co. Remon. Cor. PS 9433" in Monument Box  
per surveys by G.L.O. Gibbs and Ledy. Accepted as best available evidence of the accepted position of  
the corner.

WEST 43.70' - N&T IN 6" WILLOW  
N74°E 63.80' - N&T IN 10" MAPLE  
S35°E 65.58' - N&T IN 22" OAK  
SOUTH 455.24' - 1" ROD @ CHIPPEWA RIVER ROAD  
EAST 34.30' - TELE. RISER



Signed by Paul B. Lapham Date 6-12-95  
Surveyor's Michigan License No. 9433