

1993

COMMISSION

LAND CORNER RECORDATION CERTIFICATE
Filing Requirement of Act 74, Mich. P.A. 1970

STATE OF MICHIGAN
MIDLAND COUNTY
REMONUMENTATION & FILED

For corners in

REMONUMENTATION

Midland _____ (County)	Located In:	Corner Code #
1. Public Land Survey	T 14N R 1E	F-7
	T _____ R _____	_____
	T _____ R _____	_____
	T _____ R _____	_____
2. Property Controlling in Section	S _____ T _____ R _____	_____
	S _____ T _____ R _____	_____
3. Miscellaneous Property in Sec.	S _____ T _____ R _____	_____
	S _____ T _____ R _____	_____
4. Lot No. _____, Recorded Plat _____		
5. Private Claims _____		

30 NOV 93 3:06 P.M.
BEVERLY J THAYER
REGISTER OF DEEDS

Register of Deeds Stamp & File Number


I, Norman C. Caldwell, in a field survey on May, 19 93, do hereby certify that under requirements of P.A. 74, Michigan P.A. of 1970, the corner points mentioned in lines 1 and 2 above were in conformance with regulations and rules therefore as required in the current manual of survey instructions of the United States Department of the Interior, Bureau of Land Management or by a decree of a Court of Law and/or that the corner points mentioned in lines 3, 4 and 5 above were in conformance with the rules of the Michigan Board of Land Surveyors or by a Decree of a Court of Law, established, re-established, monumented, re-monumented, recovered, found as expressed below:

NOTE: Not more than 4 corners, all in the same town and range, may be recorded on this certificate.

A. Description of original monument and accessories and/or subsequent restoration:

(F-7) 1/4 Cor. Sec. 16 & 21, T14N-R1E

- Wood Post placed by H. Parke in 1831,
S88°W 16 lks (10.56') 11" Pepperage
S47°W 22 lks (14.52') 11" Hemlock
- Unrecorded Survey by MDOT- 1973 by M. Bennett,
Found PK Nail, Set 3/4" Pipe in Mon. Box: North 61.92'
P. Pole; S20°E 68.88' P. Pole; North 2.5' CL M-20.
- Survey by D. Ledy, Recorded in L. 4 P. 777
of Surveys, Found 3/4" Pipe in Mon. Box:
North 72.42' Guy Pole; NE 80.10' Mail Box Post
SE 68.92' Power Pole; North 4.60' C/L M-20.
- Survey by W. Ruddell, Recorded in L. 4 P. 624
of Surveys, Found Pipe in Mon. Box: N5°E 63.7'
Top Face R/W Marker; SE 68.95' MSHD Tag in P. Pole;
NW 119.0' N&C in Anchor Pole; SW 86.9' NW cor of
NW Porch Pillar.

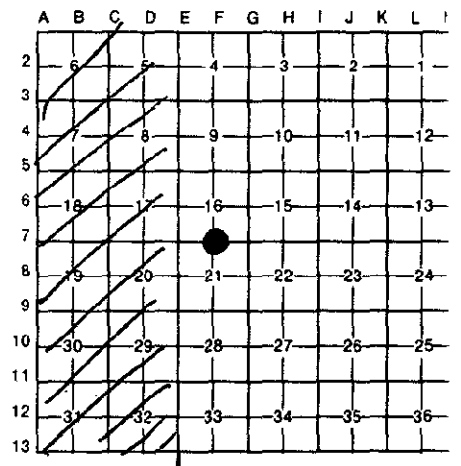

MICHIGAN
MERIDIAN

B. Description of corner evidence found and/or method applied in restoring or reestablishing corner:

(F-7) 1/4 Cor. Sec. 16 & 21, T14N-R1E


Found 3/4" Pipe in Mon. Box per L. 4 Pgs. 624 & 777.

F- 7 Approved by Midland County Peer Group October 27, 1993.

C. Description of monument for corner and accessories established to perpetuate locating the position of the corner:

(F-7) 1/4 Cor. Sec. 16 & 21, T14N-R1E

- Found 3/4" Pipe in Mon Box per surveys recorded in L 4, P 624 & 777 and is accepted as the best available evidence of the position of the original corner.
- N50°W 119.90 Guy Pole
- N05°E 72.58 Service Pole(R)
- S35°E 69.19 Power Pole(R)
- S75°W 168.43 Power Pole
- North 4.65 1/2" Bar W/12018 cap (CL M-20)

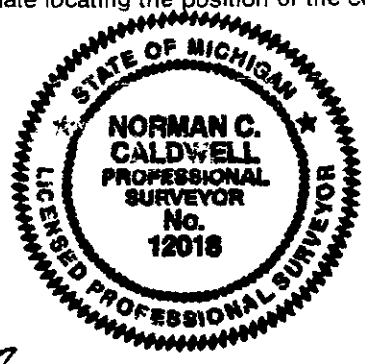

Signed by Norman C. Caldwell Date 10 NOV 93
Surveyor's Michigan License No. 12018