

APPROVED LAND CORNER
P.A. 345 OF 1990
MIDLAND COUNTY

LAND CORNER RECORDATION CERTIFICATE
Filing Requirement of Act 74, Mich. P.A. 1970

247

7/18/95 JBL

For corners in

MIDLAND (County)	Located In:	Corner Code #
1. Public Land Survey	T14N R1E	G-5
	T R	
	T R	
	T R	
2. Property Controlling in Section	S T R	
	S T R	
3. Miscellaneous Property in Sec.	S T R	
	S T R	


STATE OF MICHIGAN
MIDLAND COUNTY
REMONUMENTATION & FILED

14 AUG 95 3:05 P.M.

BEVERLY J THAYER
REGISTER OF DEEDS

Register of Deeds Stamp & File Number

4. Lot No. _____, Recorded Plat _____
5. Private Claims _____

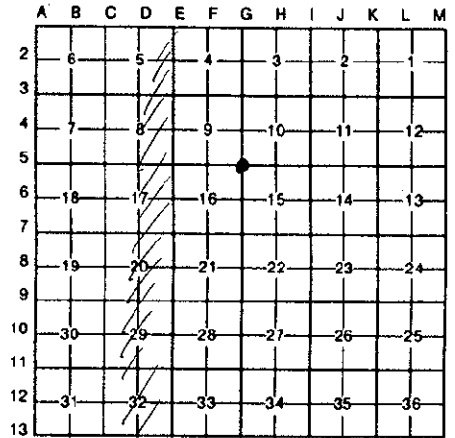

I, PAUL B. LAPHAM, in a field survey on MAY, 19 95, do hereby certify that under requirements of P.A. 74, Michigan P.A. of 1970, the corner points mentioned in lines 1 and 2 above were in conformance with regulations and rules therefore as required in the current manual of survey instructions of the United States Department of the Interior, Bureau of Land Management or by a decree of a Court of Law and/or that the corner points mentioned in lines 3, 4 and 5 above were in conformance with the rules of the Michigan Board of Land Surveyors or by a Decree of a Court of Law; established, re-established, monumented, re-monumented, recovered, found as expressed below:

NOTE: Not more than 4 corners, all in the same town and range, may be recorded on this certificate.

A. Description of original monument and accessories and/or subsequent restoration:

- G-5 Corner Common to 9, 10, 15 and 16
- 1831 HARVEY PARKE, POST, LYNN 28, N28W, 13, MAPLE 24, S16E 23
- 1900 GIBBS, STONE FOR CORNER
- 3-73 SCHAFER, FOUND IRON IN MON. BOX (132) 1-303
- 2-19-74 LAPHAM, FOUND MON. BOX LCRC #275
- 1-13-76 FLUHARTY, FOUND MON. BOX. LCRC
- 3-27-81 JONES, FOUND 1/2" PIPE IN MON. BOX (132) 3-183
- 7-10-91 LEDY, FOUND 1/2" PIPE MON. BOX (132) 4-955

WITNESS NOTE: Witnesses from above surveys and LCRC's are available in dossier file; which was presented to peer review committee and is on file at the Register of Deeds Office.

B. Description of corner evidence found and/or method applied in restoring or reestablishing corner:

- G-5 Corner Common to 9, 10, 15, and 16
- Found 3/4" x 12" Pipe per surveys by Schafer, Lapham, Fluharty, Jones and Ledy.


SURVEY & RECORDATION

1995

Corner, G-5 was approved for remonumentation at a Peer Review Committee Meeting on 7-18, 19 95.
C. Description of monument for corner and accessories established to perpetuate locating the position of the corner:

G-5 Corner Common to Sections 9, 10, 15 and 16
Set 5/8" x 18" re-rod with brass cap stamped "Midland Co. Remon. Cor. PS 9433" in Monument Box per surveys by Schafer, Lapham, Fluharty, Jones & Ledy. Accepted as best available evidence of the accepted position of the corner.

- NORTH 31.10' - N&T IN POWER POLE
- N70°E 79.10' - N&T IN POWER POLE
- S60°W 127.22' - N.E. COR. HOUSE #491
- S45°E 38.47' - "X" IN U.S.G.S. MON.
- S45°E 54.34' - N&T IN POWER POLE

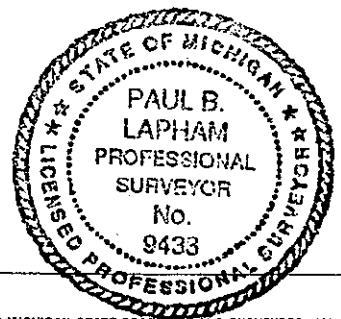

Signed by Paul B. Lapham

Date 7/21/95

Surveyor's Michigan License No. 9433