

APPROVED AND CORNER
P.A. 345 OF 1990
MIDLAND COUNTY

REMON. COR. G-8, HOMER TWP
LAND CORNER RECORDATION CERTIFICATE
Filing Requirement of Act 74, Mich. P.A. 1970

2/22/97

315

For corners in
Midland
(County)

Located in: Corner Code #
T 14N R 1E G-8
T R
T R
T R
S T R
S T R
S T R
S T R

1. Public Land Survey
2. Property Controlling in Section
3. Miscellaneous Property in Sec.
4. Lot No. _____, Recorded Plat _____
5. Private Claims _____

STATE OF MICHIGAN
MIDLAND COUNTY
REMONUMENTATION & FILED
8 DEC 97 11:02 A.M.
BEVERLY J. THAYER
Register of Deeds Stamp & File Number
REGISTER OF DEEDS

I, **RODNEY CLAYPOOL**, in a field survey on **Apr 10, 1996**, do hereby certify that under requirements of P.A. 74, Michigan P.A. of 1970, the corner points mentioned on lines 1 and 2 above were in conformance with regulations and rules therefore as required in the current manual of survey instructions of the United States Department of the Interior, Bureau of Land Management or by a decree of a Court of Law and/or that the corner points mentioned in lines 3, 4 and 5 above were in conformance with the rules of the Michigan Board of Land Surveyors or by a Decree of a Court of Law; re-established, monumented, re-monumented, recovered, found as expressed below:

	A	B	C	D	E	F	G	H	I	J	K	L	M
2	6	5	4	3	2	1							
3													
4	7	8	9	10	11	12							
5													
6	18	17	16	15	14	13							
7													
8	19	20	21	22	23	24							
9													
10	30	29	28	27	26	25							
11													
12	31	32	33	34	35	36							
13													

NOTE: Not more than 2 corners, all in the same town and range, may be recorded on this certificate.


A. Description of original monument and accessories and/or subsequent restoration:

- G-8 Corner common to Sections 21 and 22
1831, Government survey by H. Park, set corner
1913, survey of Sec 21 by Gibbs, set corrugated bar
3' x 3/4" at ave dist on true line
No date, H-W witness card, found old cor, set 3/4" pipe, stone all around
1974, H-W witness card, found 3/4" rod
1953, Hunter survey, found, set 3/4" pipe
1954, Hunter surveys, found 3/4" pipe
1956, Hunter survey, found
1963, Hunter survey, no call
1966, Hunter survey, found
1974, LCRC #309 by Schafer, found 3/4" rod
1976, rec survey by Schafer, L-2, P-96, no call
1977, rec survey by Schafer, L-2, P-230, no call
1978, rec survey by Schafer, L-2, P-511, found 3/4" rod in mon box
1984, rec survey by MacDonald, L-3, P-670, mon box
1987, rec survey by Mueller, L-3, P-959, mon box
1988, rec survey by Ledy, L-4, P-171, mon box
1989, rec survey by Jones, L-4, P-381, found buggy axle in mon box
1991, rec survey by Lady, L-4, P-970 & P-981, found 1" sq rod in mon box (bolt spike)

SURVEY & REMONUMENTATION

FEB 24 1998

SECTION

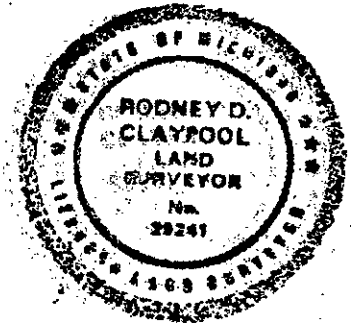

WITNESS NOTE: Witnesses from above surveys and LCRC's are available in dossier file; which was presented to peer review committee and is on file at the Register of Deeds Office.

B. Description of corner evidence found and/or method applied in restoring or reestablishing corner:

- G-8 Corner common to Sections 21 and 22
Found bolt spike in mon box per surveys by Gibbs, H-W witness card, Hunter, Schafer, MacDonald, Mueller, Ledy, Jones and LCRC by Schafer

Corner G-8 was approved for remonumentation at a Peer Review Committee Meeting on July 22, 1997.

C. Description of monument for corner and accessories established to perpetuate locating the position of the corner:

- G-8 Corner common to Sections 21 and 22
Found bolt spike in mon box, replaced spike with 3/4" pipe and brass cap stamped Midland Co. Remon Co. PS 29241, per surveys by Gibbs, H-W witness card, Hunter, Schafer, MacDonald, Mueller, Jones, and LCRC by Schafer; and is accepted to be the best available evidence of the position of the accepted corner.
N 15 Deg W, 138.55', spike in power pole
S 85 Deg E, 34.53', spike in 18" twin Ash
N 45 Deg E, 65.36', nail in 18" tree
S 30 Deg W, 139.98', nail and plastic disc in 10" Oak

Signed by Rodney D. Claypool

Date 11-26-97

Surveyor's Michigan License No. 29241

Form approved by Michigan State Board of Land Surveyors, Jan. 28, 1971

Revised May 14, 1971

Revised Jan., 1983