

REMON. COR. G-9, HOMER TWP  
LAND CORNER RECORDATION CERTIFICATE  
Filing Requirement of Act 74, Mich. P.A. 1970

316

For corners in  
Midland

(County)	Located in:	Corner Code #
1. Public Land Survey	T <u>14N</u> R <u>1E</u>	<u>G-9</u>
	T _____ R _____	_____
	T _____ R _____	_____
	T _____ R _____	_____
2. Property Controlling in Section	S _____ T _____ R _____	_____
	S _____ T _____ R _____	_____
3. Miscellaneous Property in Sec.	S _____ T _____ R _____	_____
	S _____ T _____ R _____	_____
4. Lot No. _____, Recorded Plat _____		
5. Private Claims _____		

STATE OF MICHIGAN  
MIDLAND COUNTY  
REMONUMENTATION & FILED

8 DEC 97 11:02 A.M.

BEVERLY J THAYER  
REGISTER OF DEEDS

Register of Deeds Stamp & File Number

I, RODNEY CLAYPOOL, in a field survey on Apr 10, 1996, do hereby certify that under requirements of P.A. 74, Michigan P.A. of 1970, the corner points mentioned on lines 1 and 2 above were in conformance with regulations and rules therefore as required in the current manual of survey instructions of the United States Department of the Interior, Bureau of Land Management or by a decree of a Court of Law and/or that the corner points mentioned in lines 3, 4 and 5 above were in conformance with the rules of the Michigan Board of Land Surveyors or by a Decree of a Court of Law; re-established, monumented, re-monumented, recovered, found as expressed below:

**NOTE: Not more than 2 corners, all in the same town and range, may be recorded on this certificate.**

	A	B	C	D	E	F	G	H	I	J	K	L	M
2	6	5	4	3	2	1							
3													
4	7	8	9	10	11	12							
5													
6	18	17	16	15	14	13							
7													
8	19	20	21	22	23	24							
9													
10	30	29	28	27	26	25							
11													
12	31	32	33	34	35	36							
13													


A. Description of original monument and accessories and/or subsequent restoration:

- G-9 Corner common to Sections 21, 22, 27 and 28
- 1831, Government survey by H. Park, set corner
- 1902, survey of Sec 27 by Gibbs, iron under fence
- 1913, survey of Sec 21 by Gibbs, old corner post standing set 1/2" x 3' corrugated rod
- No date, H-W witness card, found old corner stone and rasp with 1" pipe beside rasp (file)
- 1955, Hunter surveys, found
- 1979, rec survey by Schafer, L-2, P-839, no call
- 1980, rec survey by Jones, L-3, P-101, no call
- 1984, rec survey by McDonald, L-3, P-670, found 3/4" pipe
- 1989, rec survey by Jones, L-4, P-381, found 1" pipe, 8" deep, old witnessess ok
- 1991, rec survey by Jones, L-4, P-816, no call

SURVEY & REMONUMENTATION

FEB 24 1998

SECTION

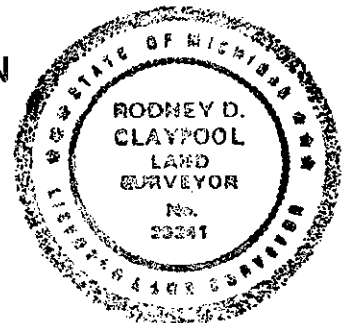

WITNESS NOTE: Witnesses from above surveys and LCRC's are available in dossier file; which was presented to peer review committee and is on file at the Register of Deeds Office.

B. Description of corner evidence found and/or method applied in restoring or reestablishing corner:

- G-9 Corner common to Sections 21, 22, 27 and 28
- Found 3/4" pipe per surveys by Gibbs, H-W witness card, Hunter, Schafer, Jones, MacDonald and LCRC by Jones

Corner G-9 was approved for remonumentation at a Peer Review Committee Meeting on July 22, 1997.

C. Description of monument for corner and accessories established to perpetuate locating the position of the corner:

- G-9 Corner common to Sections 21, 22, 27 and 28
- Found 3/4" pipe per surveys by Gibbs, H-W witness card, Hunter, Schafer, Jones, MacDonald and LCRC by Jones, and is accepted to be the best available evidence of the position of the original corner.
- N 45 Deg E, 2.20', nail in power pole type gate post
- N 30 Deg W, 16.12', nail and disc in 30" Oak
- N 80 Deg W, 17.58', nail and disc in 30" Oak
- West, 17.05', nail and disc in power pole type post
- West, 7.2', corner fence post
- South, 1.0', E and W fence

Signed by Rodney D. Claypool

Date 11-26-97

Surveyor's Michigan License No. 29241