

APPROVED LAND CORNER
P.A. 345 OF 1990
MIDLAND COUNTY

278

LAND CORNER RECORDATION CERTIFICATE
Filing Requirement of Act 74, Mich. P.A. 1970

2/12/96 JBJ

For corners in

<u>MIDLAND</u> (County)	Located In:	Corner Code #
1. Public Land Survey	T 14NR 1E	K-5
	T R	
	T R	
	T R	
2. Property Controlling in Section	S T R	
	S T R	
3. Miscellaneous Property in Sec.	S T R	
	S T R	

STATE OF MICHIGAN
MIDLAND COUNTY
REMONUMENTATION & FILED

27 NOV 96 2:52 P.M.

BEVERLY J THAYER
REGISTER OF DEEDS

Register of Deeds Stamp & File Number

4. Lot No. _____, Recorded Plat _____
5. Private Claims _____

I, PAUL B. LAPHAM, in a field survey on NOVEMBER 19 95 do hereby state that under requirements of P.A. 74, Michigan P.A. of 1970, the corner points mentioned in lines 1 and 2 above were in conformance with regulations and rules therefore as required in the current manual of survey instructions of the United States Department of the Interior, Bureau of Land Management or by a decree of a Court of Law and for that the corner points mentioned in lines 3, 4 and 5 above were in conformance with the rules of the Michigan Board of Land Surveyors or by a Decree of a Court of Law; established, re-established, monumented, recovered, found as expressed below:

A	B	C	D	E	F	G	H	I	J	K	L	M
1												
2	6	5	4	3	2	1						
3												
4	7	8	9	10	11	12						
5												
6	18	17	16	15	14	13						
7												
8	19	20	21	22	23	24						
9												
10	30	29	28	27	26	25						
11												
12	31	32	33	34	35	36						
13												

NOTE: Not more than 2 corners, all in the same town and range, may be recorded on this certificate.


- A. Description of original monument and accessories and/or subsequent restoration:
- 1831 PARKE SET POST
WIT.-BEECH 18" N14°E 37 LKS.
B. ASH 8" S38°W 25 LKS.
 - 7-12-79 SCHAFER, (132) 2-865
SAME AS 6-08-79
 - 2-25-10 GIBBS, C.S.R.
COR. POST OF FENCE
 - 4-11-83 LEDY, (132) 3-654
FOUND 5/8" BAR 8" E. OF CENTERLINE OF PVM'T & 500' NORTH OF RIVER
 - 1-26-14 GIBBS, C.S.R.
COR. POST OF FENCE FOR COR.
 - 6-08-79 SCHAFER, (132) 2-848
FOUND MON. RAISED WITH 3/4" PIPE
8" E. OF CENTERLINE GRAVEL ROAD

B. Description of corner evidence found and/or method applied in restoring or reestablishing corner:
FOUND 5/8"x18" IRON IN ASPHALT, 9.2 FEET EAST OF CENTERLINE. MEASURED 500 FEET SOUTH TO RIVER AND 2631.43 FEET (LEDY, 2631.23' AND GIBBS, 2634.72') TO K-6

Corner, K-5 was approved for remonumentation at a Peer Review Committee Meeting on JAN 12, 1996.

C. Description of monument for corner and accessories established to perpetuate locating the position of the corner:
SET 3/4"x18" GAS PIPE WITH BRASS CAP STAMPED "MIDLAND CO. REMON. COR. P.S. 9433" IN MONUMENT BOX. ACCEPTED AS BEST AVAILABLE EVIDENCE OF THE ACCEPTED POSITION OF THE CORNER.

WITNESSES:
S10°E, 32.75' - E. END 24" C.M.P.
S35°W, 45.56' - W. END 24" C.M.P.
N07°W, 361.37' - NAIL & TAG IN POWER POLE.
WEST, 9.2' - CENTERLINE OF ASPHALT PVM'T.

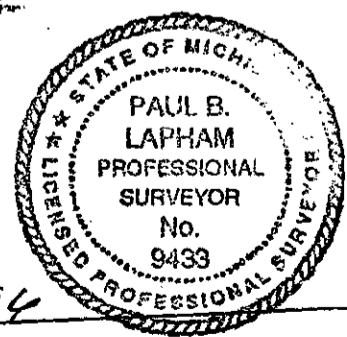

Signed by Paul B. Lapham
Surveyor's Michigan License No. 9433

Date 10-4-94