

APPROVED LAND CORNER  
P.A. 345 OF 1990  
MIDLAND COUNTY

REMON. COR. M-13, HOMER TWP.  
LAND CORNER RECORDATION CERTIFICATE  
Filing Requirement of Act 74, Mich. P.A. 1970

210

*4/25/95 J.P.C.*

For corners in  
Midland  
(County)

	Located In:	Corner Code #
1. Public Land Survey	T 14N R 1E	M-13
	T ___ R ___	_____
	T ___ R ___	_____
	T ___ R ___	_____
2. Property Controlling in Section	S ___ T ___ R ___	_____
	S ___ T ___ R ___	_____
3. Miscellaneous Property in Sec.	S ___ T ___ R ___	_____
	S ___ T ___ R ___	_____
4. Lot No. _____, Recorded Plat _____		
5. Private Claims _____		

STATE OF MICHIGAN  
MIDLAND COUNTY  
FILED

11 MAY 95 3:18 P.M.

BEVERLY J THAYER  
REGISTER OF DEEDS

Register of Deeds Stamp & File Number

I, RODNEY CLAYPOOL, in a field survey on FEBRUARY 2, 1994, do hereby certify that under requirements of P.A. 74, Michigan P.A. of 1970, the corner points mentioned on lines 1 and 2 above were in conformance with regulations and rules therefore as required in the current manual of survey instructions of the United States Department of the interior, Bureau of Land Management or by a decree of a Court of Law and/or that the corner points mentioned in lines 3, 4 and 5 above were in conformance with the rules of the Michigan Board of Land Surveyors or by a Decree of a Court of Law; re-established, monumented, re-monumented, recovered, found as expressed below:


	A	B	C	D	E	F	G	H	I	J	K	L	M
2	6	5	4	3	2	1							
3													
4	7	8	9	10	11	12							
5													
6	18	17	16	15	14	13							
7													
8	19	20	21	22	23	24							
9													
10	30	29	28	27	26	25							
11													
12	31	32	33	34	35	36							
13													

**NOTE: Not more than 4 corners, all in the same town and range, may be recorded on this certificate.**

A. Description of original monument and accessories and/or subsequent restoration:

M-13 Corner common to 4 Townships (T14N R1 & 2E & T13N R1 & 2E)

Government survey 1831, set post B. Ash 11" S 47 Deg W, 24 L. (15.84') Elm 14" N 44 1/2 Deg W, 46 L. (30.36') Survey by M. Hunter, 1946, found stone with old stake beside it. Survey by M. Hunter, 1952, 1954, 1955, 1956, found large stone Survey by P. Lapham, 1977, found corner.	Survey by D. Ledy, 1983, found bar in mon box at West edge of pvmt. of Badour Road and centerline Gordonville Road Survey by D. Ledy, 1988, found 1" pipe in mon box Survey by J. Jones, 1988, found corner Survey by B. Jones, 1992, found as per LCR 456 mon box LCRC by J. Schafer, #456
---	---

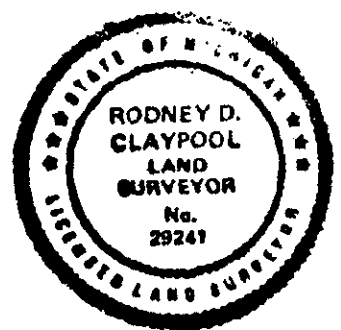

WITNESS NOTE: Witnesses from above surveys and LCRC's are available in dossier file; which was presented to peer review committee and is on file at the Register of Deeds Office.

B. Description of corner evidence found and/or method applied in restoring or reestablishing corner:

M-13 Corner common to 4 Townships (T14N R1 & 2E & T13N R1 & 2E)  
Found 3/4" pipe in mon box (replaced pipe with 5/8" rod and brass cap) per surveys by M. Hunter, P. Lapham, D. Ledy, J. Jones, B. Jones and LCRC by J. Schafer

Corner M-13 was approved for remonumentation at a Peer Review Committee Meeting on April 15, 1995.

C. Description of monument for corner and accessories established to perpetuate locating the position of the corner:

M-13 Corner common to 4 Townships (T14N-R1 & 2E & T13N-R1 & 2E)

Found 3/4" pipe in mon box (replaced pipe with 5/8" rod and brass cap stamped Midland Co. Remon Cor. PS 29241) per surveys by M. Hunter, P. Lapham, D. Ledy, J. Jones, B. Jones, and LCRC by J. Schafer and is accepted as the best available evidence of the position of the original corner.

N 40 Deg E, 84.58', SW cor building (store)	S 45 Deg E, 88.75', NW corner old school building
N 45 Deg E, 50.64', nail and plastic disc in power pole	S 45 Deg W, 57.82', nail and disc in power pole

Signed by Rodney D. Claypool Date 05-11-95