

**MIDLAND COUNTY REMONUMENTATION  
LAND CORNER RECORDATION CERTIFICATE**  
Filing Requirement of Act 74, Mich. PA 1970

Midland (County)	Located In	Corner Code #
1. Public Land Survey	T <u>14N</u> R <u>1W</u>	<u>A2</u>
	T <u>14N</u> R <u>2W</u>	<u>M2</u>
2. Property Controlling in Section	S _____ T _____ R _____	_____
	S _____ T _____ R _____	_____
3. Miscellaneous Property in Section	S _____ T _____ R _____	_____
	S _____ T _____ R _____	_____


**Register of Deeds Stamp & File Number**

4. Lot No: \_\_\_\_\_ Recorded Plat: \_\_\_\_\_

5. Private Claims: \_\_\_\_\_

I, Craig W. McVean, in a field survey on Sept. 20, 2011 do hereby state that under requirements of PA 74, Michigan PA of 1970, the corner points mentioned in lines 1 and 2 above were in conformance with regulations and rules therefore as required in the current manual of survey instructions of the United States Department of the Interior, Bureau of Land Management or by a decree of a Court of Law and/or that the corner points mentioned in lines 3, 4 and 5 above were in conformance with the rules of the Michigan Board of Land Surveyors or by a Decree of a Court of Law; established, re-established, monumented, recovered, found as expressed below:

**NOTE: Not more than 2 corners, all in the same town and range, may be recorded on this certificate.**

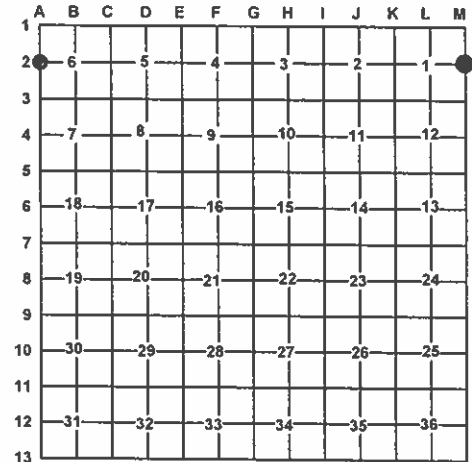

**A. Description of original monument and accessories and/or subsequent restoration:**

A2 & M2 – 1830 – GLO – ¼ Post – R. Clark, Jr.  
 1) B. Oak 13" S28°W 23 L.  
 2) Hemlock 12" N15°W 28 L.  
 3) 4 chains N. – Brook 10 NE Swampy  
 - 1923 – F. J. Gibbs – CSR – FB – T14N, R1W, p. 122 & 123  
 Set Post for corner  
 4) Pine Stp. E 97  
 5) Pine Stp. W. 47

**B. Description of corner evidence found and/or method applied in restoring or re-establishing corner:**

A2 & M2 – Standard ¼ Corner common to Sec. 6, T14N, R1W and Sec. 1, T14N, R2W – Fd. both of Gibbs BT remains. Dug 5'± x 5'± area searching for evidence of stake but nothing was found. No GLO evidence. Both of Gibbs' PS BT's were 4'± in diameter. Set spikes at the face ± of each other. Measured grid bearing and distance of N86°36'W 96.02' (95.14' – FJG) between the spikes. Set stamped 4" DNR Alum. Cap on 1" x 3' long galv. iron pipe on line between Gibbs' BT's at the proportional distance. Measured North 270' (264' – GLO) to channel of small stream. This position fits Gibbs' survey dimensions N & E. DNR Monument accepted as the best available evidence of the position of the original corner.

**C. Description of monument for corner and accessories established to perpetuate locating the position of the corner:**

A2 & M2 – Stamped 4" DNR Alum. Cap on 1" x 36" long galv. iron pipe. Set Blue Carsonite Post 1' N.  
 N68°E 17.75' to set N & T in NW side 10" Oak scribed 'XBT'  
 S1°E 22.47' to set N & T in W side 16" Red Maple scribed 'XBT'  
 N55°W 13.75' to set N & T in NE side 23" Red Maple scribed 'XBT'  
 S75°W 21.18' to set N & T in N. side 6" Oak



Signed by: Craig W. McVean  
 Surveyor's Michigan License No.: 39088

Date: 10/15/2012